

HANCOCK  
F 15

WATER WELL DRILLERS LOG

**CODED**

311

Date: 7-28, 1961, Driller: Sutter Well Wks County Hancock

(Name)

(1) Owner of Land: E. Harris  
(Name)  
4654 Laine Ave N.O. La.  
(Address)

(2) Location: 3 7 15  
8 miles W of Bay St Louis  
(distance) (direction) (Nearest Town)

(3) Topography: flat  
(Hilly) (Flat) (Level)

(4) Purpose of Well: domestic  
(Domestic Irrigation  
Municipal, Industrial, Other)

Description & Color of Materials Sand, Clay, Red Clay, Shell, etc.	Thick- ness Feet	Depth Feet
Clay	18	18
sand	17	35
Clay	35	70
sand	15	85
Clay	50	135
sand	15	150

Information upon completion of well:

(1) Diameter 2 inches.

(2) Total Depth 150 feet.

(3) Water Level 6 feet below top of ground.

(4) Cased to all, Size 2"

(5) Screen: Size 2", Length 5'


(6) Were any formations sealed against pollution?  
no.

If YES depth of formation \_\_\_\_\_

Why \_\_\_\_\_

Drillers Remarks: \_\_\_\_\_

**CODED**

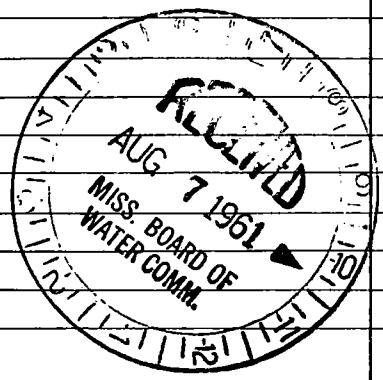

(Use Back Side)

Well No.

1961

Madison All Rocha

United Army leaving