

F17
3-15-63

WATER WELL DRILLERS LOG

CODED F

Date: 3-15, 1963, Driller: J. Beall County Hancock
(Name)

(1) Owner of Land: E. J. Merritt
(Name)
516 Ridgeman Drive NOLA
(Address)

(2) Location: SE 1/4, NW 1/4, Sec. 1 T7R15
5 miles North of Nibbs
(distance) (direction) (Nearest Town)

(3) Topography: (Hilly) (Flat) (Level)

(4) Purpose of Well: Home
(Domestic Irrigation, Municipal, Industrial, Other)

Description & Color of Materials Sand, Clay, Red Clay, Shell, etc.	Thick- ness Feet	Depth Feet
<u>Red Clay</u>	<u>10</u>	<u>10</u>
<u>Sand + Mud</u>	<u>100</u>	<u>110</u>
<u>White sand</u>	<u>79</u>	<u>189</u>
<u>Hard Blue mud</u>	<u>52</u>	<u>241</u>
<u>water strata</u>	<u>50</u>	<u>291</u>
<u>Total</u>		<u>291 ft</u>

Information upon completion of well:

(1) Diameter 2 1/4 inches.

(2) Total Depth 291 feet.

(3) Water Level 53 feet below top of ground.

(4) Cased to _____, Size _____

(5) Screen: Size 1/4", Length 10


(6) Were any formations sealed against pollution?
Close
yes, _____ no.

If YES depth of formation _____

Why _____

Drillers Remarks: _____

CODED

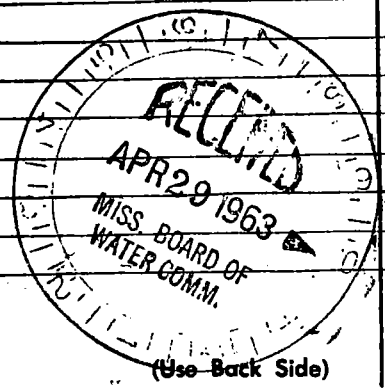

Well No.

