

HANCOCK
F 18
5-1-71

MISSISSIPPI
BOARD OF WATER COMMISSIONERS
416 North State Street
Jackson, Mississippi 39201

CODED

WATER WELL DRILLERS LOG

Hancock
Red Bank

5-1-71, 19 date well completed

Bird Kuntz's Son firm name

countv well located

LANDOWNERS *Dennis Curlew*
Kiln
Occupant, Dennis

description of formations encountered

from to
0 24
24 49
49 50
51 69

(mailing address)

WELL LOCATION:

sec 33 T 7 N R 15
S
miles of (distance) (direction) (nearest town)
Kiln

WELL PURPOSE:

(home, irrigation, municipal, industrial)

WELL COMPLETION DATA:

(1) diameter (inches) 2 in
(2) total depth (feet) 69
(3) static water level (feet) 48 below above top of ground.
(4) casing Galv. 64
(material) (depth)

CODED

(size) If telescope see back.

(5) screen 5 64
(length) (depth to top)
2 x 5 2 x 5
(size) (material)

(6) pump (HP) (yield gpm)

(type power)

(7) electric log no
(yes or no)

(organization running log)

(8) how well bottom plugged
Good Shuck

DRILLERS REMARKS: no
pump furnished

JUL 6 1971

MISS. BD. OF
WATER COM.

If well telescopes please sketch and show depths...


Handwritten notes and sketch at the top of the page.

GROUND LEVEL

Handwritten notes on the left side of the page.

Handwritten notes in the middle-left section of the page.

Handwritten notes at the top right of the page.

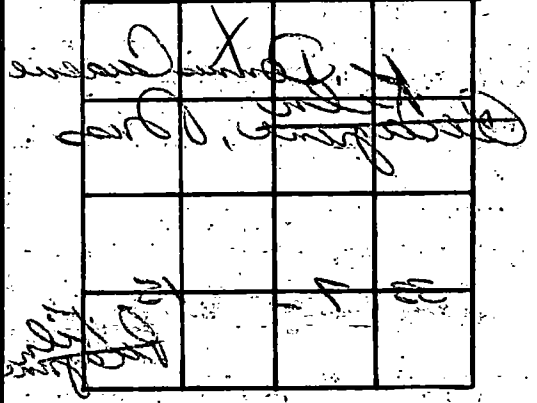

SECTION

Please indicate well location X.

ADDITIONAL INFORMATION

Multiple lines of handwritten text providing additional information.

If more than one screen, show locations of each on sketch.