

Hancock
F-20
8-19-71

MISSISSIPPI
BOARD OF WATER COMMISSIONERS
416 North State Street
Jackson, Mississippi 39201

WATER WELL DRILLERS LOG

CODED

aug. 19 19 71 MORAN'S Well Works Hancock
Date well completed firm name county well located

LANDOWNER:	description of formations encountered	from	to
Mitchell's service sta.			
Kien, miss. (mailing address)	CLAY	0	65
	SAND	65	75
	CLAY	75	90
WELL LOCATION:	SAND	90	120
sec. 30 T. 7 N. R. 15 E.	CLAY	120	155
(distance) 12 miles N of Bay St Louis	SAND	155	205
(direction) (nearest town)	CLAY	205	222
	SAND	222	262
WELL PURPOSE: industrial (home, irrigation, municipal, industrial)			
WELL COMPLETION DATA:			
(1) diameter (inches) 2"			
(2) total depth (feet) 262"			
(3) static water level (feet) 8' below top of ground			
(4) casing galv. 252' (material) (depth)			
(size) If telescope see back.			
(5) screen 10' (length) (depth to top)			
10.75" stainless steel (size) (material)			
(6) pump (HP) (yield gpm)			
elec. (type power)			
(7) electric log no. (yes or no)			
(organization running log)			
(8) how well bottom plugged BACK WASH VALVE			
DRILLERS REMARKS:			


CODED

SEP 16 1971

MISS. BD. OF
WATER COMM.

If well telescopes please sketch and show depths.

GROUND LEVEL

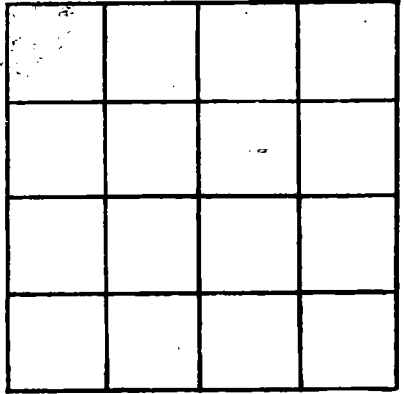

SECTION _____

Please indicate well location X.

ADDITIONAL INFORMATION

If more than one screen, show locations of each on sketch.