

MISSISSIPPI
BOARD OF WATER COMMISSIONERS
416 North State Street
Jackson, Mississippi 39201

WATER WELL DRILLERS LOG

HANCOCK
F21
12-27-71

12-27 1971 Earl Penton water wellers Hancock
date well completed firm name county well located


LANDOWNER:	description of formations encountered	from	to
<u>Charles Moran</u> <u>Kiln Miss.</u> (mailing address)			
WELL LOCATION:	<u>Coarse white sd. & cr.</u>	<u>14</u>	<u>19</u>
sec <u>24</u> T <u>7</u> N R <u>15</u> E	<u>white clay</u>	<u>19</u>	<u>33</u>
<u>1</u> miles <u>West</u> of <u>Kiln</u> (distance) (direction) (nearest town)	<u>Blue clay</u>	<u>33</u>	<u>176</u>
WELL PURPOSE: <u>Home</u> (home, irrigation, municipal, industrial)	<u>Coarse blue sd.</u>	<u>176</u>	<u>206</u>
WELL COMPLETION DATA:			
(1) diameter (inches) <u>4 3/4</u>			
(2) total depth (feet) <u>205</u>			
(3) static water level (feet) <u>24</u> below above top of ground.			
(4) casing <u>Galv.</u> <u>200</u> (material) (depth)			
<u>2"</u> (size) if telescope see back.			
(5) screen <u>5'</u> <u>200</u> (length) (depth to top)			
<u>2"</u> <u>5.5</u> (size) (material)			
(6) pump <u>1</u> <u>430 Hrs.</u> (HP) (yield gpm)			
<u>Elect</u> (type power)			
(7) electric log <u>NO</u> (yes or no)			
(organization running log)			
(8) how well bottom plugged <u>shoe</u>			
DRILLERS REMARKS:			

MAR 29 1972

MISS. BD. OF
WATER COMM.

If well telescopes please sketch and show depths.

GROUND LEVEL

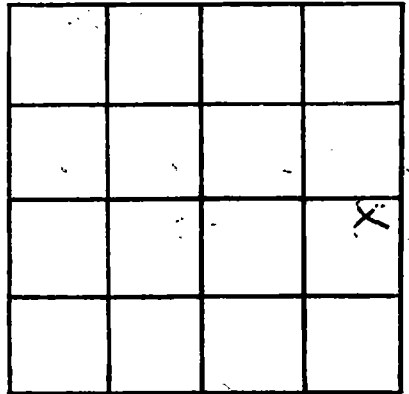

SECTION 24

Please indicate well location X.

ADDITIONAL INFORMATION

If more than one screen,
show locations of each on sketch.