

CODED

MISSISSIPPI  
BOARD OF WATER COMMISSIONERS  
416 North State Street  
Jackson, Mississippi 39201

CODED

WATER WELL DRILLERS LOG

Hancock  
725  
4-24-68

4-24  
date well completed

1968 Pineville Water Well  
firm name

Hancock  
county well located

LANDOWNER: Robert Lyons

Rt 1

Kiln, Miss  
(mailing address)

WELL LOCATION:

sec 24 T 7 N R 15 E  
S W  
3 miles W of Kiln  
(distance) (direction) (nearest town)

WELL PURPOSE: Home  
(home, irrigation, municipal, industrial)

WELL COMPLETION DATA:

- (1) diameter (inches) 2"
- (2) total depth (feet) 218'
- (3) static water level (feet) 16 below top of ground.
- (4) casing gal 208  
(material) (depth)

         if telescope see back.  
(size)

- (5) screen 10 208  
(length) (depth to top)
- 2" S.S.  
(size) (material)

- (6) pump 1 750 h  
(HP) (yield gpm)
- Ele.  
(type power)

- (7) electric log No.  
(yes or no)

          
(organization running log)

- (8) how well bottom plugged spring clay

DRILLERS REMARKS:

description of formations encountered	from	to
<u>chert &amp; pea gravel</u>	<u>0'</u>	<u>16'</u>
<u>Blue clay</u>	<u>16'</u>	<u>195'</u>
<u>sand &amp; Blue pea gravel from</u>	<u>195'</u>	<u>218'</u>
<u>app 23 ft water sand &amp; gravel.</u>		


CODED

DEC 10 1968

MISS. BD. OF  
WATER COMM.

If well telescopes please sketch and show depths.

GROUND LEVEL

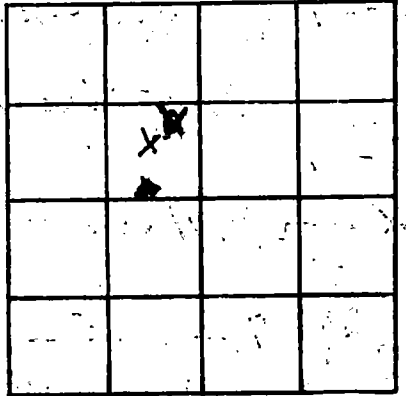

SECTION 24

Please indicate well location X.

ADDITIONAL INFORMATION

If more than one screen, show locations of each on sketch.