

CODED

MISSISSIPPI
BOARD OF WATER COMMISSIONERS
416 North State Street
Jackson, Mississippi 39201

Hancock
26
1-31-69

WATER WELL DRILLERS LOG

1-31 1969 Sutton Well Works Hancock
date well completed firm name county well located

LANDOWNER: J. J. DOYLE

description of formations encountered	depth	
	from	to
<u>Clay</u>	<u>0</u>	<u>15</u>
<u>Sand</u>	<u>15</u>	<u>35</u>
<u>Clay</u>	<u>35</u>	<u>148</u>
<u>Sand</u>	<u>148</u>	<u>163</u>
<u>Clay</u>	<u>163</u>	<u>357</u>
<u>Sand</u>	<u>357</u>	<u>388</u>

Pearlington Miss.
(mailing address)

WELL LOCATION: Highway 43
sec. 2 T. 7N R. 15E S. 5
miles 1.4 of Kilns
(distance) (direction) (nearest town)

WELL PURPOSE: home
(home, irrigation, municipal, industrial)

WELL COMPLETION DATA:

(1) diameter (inches) 2

(2) total depth (feet) 388

(3) static water level (feet) 7 below top of ground

(4) casing galv. 378'
(material) (depth)

2" If telescope see back.
(size)

(5) screen 10' 378'
(length) (depth to top)

2" Stainless Steel
(size) (material)

(6) pump 3/4 15
(HP) (yield gpm)

elec
(type power)

(7) electric log no
(yes or no)

(organization running log)


(8) how well bottom plugged B.P. Value

DRILLERS REMARKS:

FREE
MINE BUREAU
WATER BOARD

If well telescopes please sketch and show depths.

GROUND LEVEL

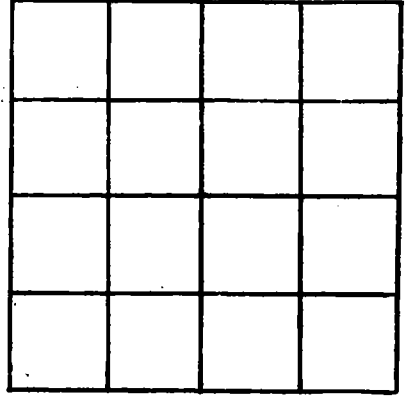

SECTION _____

Please indicate well location X.

ADDITIONAL INFORMATION

If more than one screen, show locations of each on sketch.