

CODED

MISSISSIPPI  
BOARD OF WATER COMMISSIONERS  
416 North State Street  
Jackson, Mississippi 39201

WATER WELL DRILLERS LOG

Hancock  
727  
3-13-69

3-13 1969 Penton well serv Hancock  
date well completed firm name county well located

LANDOWNER: Charles Thomas  
Rt. 3 Box 313A  
Picayune MISS  
(mailing address)

description of formations encountered	from	to
<u>Surface Clay</u>	<u>0</u>	<u>22</u>
<u>Sand</u>	<u>22</u>	<u>56</u>
<u>White clay</u>	<u>56</u>	<u>64</u>
<u>Brown clay</u>	<u>64</u>	<u>70</u>
<u>Blue clay</u>	<u>70</u>	<u>157</u>
<u>Grey sand</u>	<u>157</u>	<u>195</u>

WELL LOCATION:  
sec. 34 T 7 S R 15 W  
5 miles NW of Kila  
(distance) (direction) (nearest town)

WELL PURPOSE: Home  
(home, irrigation, municipal, industrial)

WELL COMPLETION DATA:

(1) diameter (inches) 2

(2) total depth (feet) 195

(3) static water level (feet) 33 below top of ground.

(4) casing Calk 190'  
(material) (depth)

2" if telescope see back.  
(size)

(5) screen 5' 190  
(length) (depth to top)

012 2" S. Steel  
(size) (material)

(6) pump 1 12  
(HP) (yield gpm)

Elec  
(type power)

(7) electric log NO  
(yes or no)

(organization running log)

(8) how well bottom plugged Bw Valve

CODED

CODED


MAR 17 1969

MISS. BD. OF  
WATER COMM.

DRILLERS REMARKS:

If well telescopes please sketch and show depths.

GROUND LEVEL

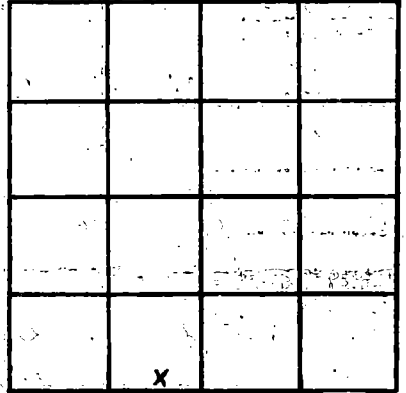

34

SECTION

Please indicate well location X.

ADDITIONAL INFORMATION

If more than one screen, show locations of each on sketch.