

A

CODED

Dtn 7/28/69  
part 8/1/69  
Rtn 8/1/69

CODED

OK  
9/1/69  
M/bayen

Hancock  
F 28  
7-9-69

MISSISSIPPI  
BOARD OF WATER COMMISSIONERS  
416 North State Street  
Jackson, Mississippi 39201

WATER WELL DRILLERS LOG

CODED

7-9 1969 W.S. Water Well Serv. Hancock  
date well completed firm name county well located

LANDOWNER: Morson  
Hill House  
Kiln Road.  
(mailing address)

description of formations encountered	from	to
<u>Red clay</u>	<u>0</u>	<u>10</u>
<u>Fine white sd</u>	<u>10</u>	<u>18</u>
<u>Wh. Ye clay</u>	<u>18</u>	<u>20</u>
<u>Blue clay</u>	<u>20</u>	<u>125</u>
<u>Blue mgd. sand</u>	<u>125</u>	<u>153</u>

WELL LOCATION:  
sec. 21 T 7 N R 15 E  
3 1/2 miles NE of Star road  
(distance) (direction) (nearest town)

WELL PURPOSE: Home  
(home, irrigation, municipal, industrial)

- WELL COMPLETION DATA:
- (1) diameter (inches) 7 1/2
  - (2) total depth (feet) 153
  - (3) static water level (feet) 28 below top of ground
  - (4) casing Cold. (material), 148 (depth)  
2" (size) if telescope see back.
  - (5) screen 5 (length), 148 (depth to top)  
2" (size), 5. Steel (material)
  - (6) pump 1/2 (HP), 400 (yield gpm)  
Elect. (type power)
  - (7) electric log no (yes or no)
  - (8) how well bottom plugged 5' or


JUL 2 1969

MISS. Bd. ON  
WATER COM.

DRILLERS REMARKS:  
E.B. Kenton

If well telescopes please sketch and show depths.

GROUND LEVEL

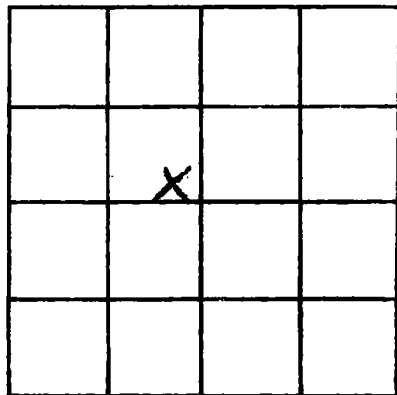

SECTION 21

Please indicate well location X.

ADDITIONAL INFORMATION

If more than one screen, show locations of each on sketch.