

ARMY - no Local Address

Hancock
F 29
12-12-69

MISSISSIPPI
BOARD OF WATER COMMISSIONERS
416 North State Street
Jackson, Mississippi 39201

CODED
CODED

69 WATER WELL DRILLERS LOG

12-12 date well completed 1969 Penton Well Serv Hancock county well located

LANDOWNER: EL. Wadnier

description of formations encountered

from to

Surface Clay	0	16
Red Sand	16	48
Red Clay	48	70
White Clay	70	78
Blue Clay	78	275
Grey Sand	275	310
Blue Clay	310	395
Grey Sand	395	440
Blue Clay	440	505
Grey Sand	505	552
Blue Clay	552	660
Grey Sand	660	715
Blue Clay	715	1060
Fine Sand	1060	1110
Blue Clay	1110	1216
Grey Sand	1216	1302

(mailing address)

WELL LOCATION:

sec. 13 T. 7 R. 15 S. W.

2 1/2 miles NW of Kiln (distance) (direction) (nearest town)

WELL PURPOSE: Home (home, irrigation, municipal, industrial)

WELL COMPLETION DATA:

- (1) diameter (inches) 2
- (2) total depth (feet) 1302
- (3) static water level (feet) Flow above top of ground

(4) casing Black, 1282 (material) (depth)

2" (size) If telescope see back.

(5) screen 20' 1282 (length) (depth to top)

2" 5. Steel (size) (material)

(6) pump (HP) (yield gpm)

(type power)

(7) electric log NO (yes or no)

(organization running log)

(8) how well bottom plugged B.W. Value

JAN 12 1970


DRILLERS REMARKS:

18 lbs. Pressure at Ground level

MISS. BD. OF WATER COMM.

If well telescopes please sketch and show depths.

GROUND LEVEL

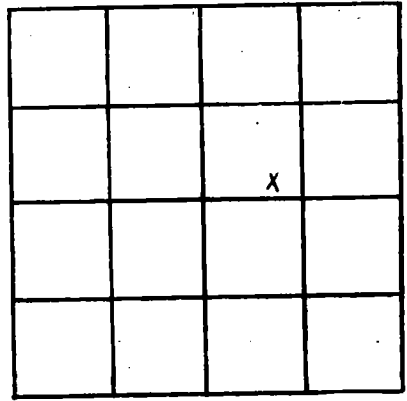

SECTION 13

Please indicate well location X.

ADDITIONAL INFORMATION

Lined area for additional information.

If more than one screen, show locations of each on sketch.