

HANCOCK  
F 33  
10-13-70

MISSISSIPPI  
 BOARD OF WATER COMMISSIONERS  
 416 North State Street  
 Jackson, Mississippi 39201

**CODED**

WATER WELL DRILLERS LOG

10-13  
 date well completed

1970 Singer-Layne Central Div.  
 firm name

Hancock  
 county well located

LANDOWNER:

Chicken Chef Septers, Inc.

(mailing address)

WELL LOCATION:

sec. 33 T 7 S R 15 W  
 (distance) miles (direction) of (nearest town)

WELL PURPOSE:

(home, irrigation, municipal, industrial)

WELL COMPLETION DATA:

- (1) diameter (inches) 16"
- (2) total depth (feet) 1681'
- (3) static water level (feet) 92' <sup>below</sup> top of ground.
- (4) casing Steel 1570'  
 (material) (depth)  
16" if telescope see back.  
 (size)
- (5) screen 100' 1570'  
 (length) (depth to top)  
10" Stainless Steel  
 (size) (material)
- (6) pump none  
 (HP) (yield gpm)
- (type power)
- (7) electric log no  
 (yes or no)
- (organization running log)
- (8) how well bottom plugged Slugs

description of formations encountered

from to

<u>Yellow Clay</u>	<u>0</u>	<u>20</u>
<u>Opaky Clay</u>	<u>20</u>	<u>29</u>
<u>Sand and Gravel</u>	<u>29</u>	<u>114</u>
<u>Clay Clay</u>	<u>114</u>	<u>132</u>
<u>Brittle Clay</u>	<u>132</u>	<u>470</u>
<u>Clay sand water sand</u>	<u>470</u>	<u>478</u>
<u>Sand</u>	<u>478</u>	<u>506</u>
<u>Shale and Fine Sand</u>	<u>506</u>	<u>630</u>
<u>Sand</u>	<u>630</u>	<u>690</u>
<u>Shale and Fine Sand</u>	<u>690</u>	<u>785</u>
<u>Sand</u>	<u>785</u>	<u>870</u>
<u>Shale</u>	<u>870</u>	<u>1120</u>
<u>Shale &amp; Shale of Shale</u>	<u>1120</u>	<u>1220</u>
<u>Shale</u>	<u>1220</u>	<u>1500</u>
<u>Shale &amp; Shale</u>	<u>1500</u>	<u>1634</u>
<u>Shale</u>	<u>1634</u>	<u>1640</u>
<u>Shale</u>	<u>1640</u>	<u>1830</u>
<u>Shale</u>	<u>1830</u>	<u>1830</u>

**CODED**

OCT 19 1970


MISS. BD. OF  
 WATER COMME.

DRILLERS REMARKS:

*mailed to Board of Water Commissioners 10/19/70*

If well telescopes please sketch and show depths.

GROUND LEVEL

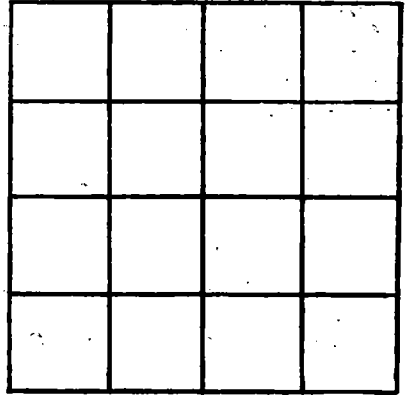

SECTION \_\_\_\_\_

Please indicate well location X.

ADDITIONAL INFORMATION

If more than one screen, show locations of each on sketch.