

HANCOCK
F36
11-19-70

MISSISSIPPI
 BOARD OF WATER COMMISSIONERS
 416 North State Street
 Jackson, Mississippi 39201

WATER WELL DRILLERS LOG

CODED

11-19 1970 Parsons Well Serv HANCOCK
 date well completed firm name county well located

LANDOWNER: Harold Nezaise

description of formations encountered

from to

Kiln Miss
 (mailing address)

Surface Clay	0	18
Sand	18	38
White Clay	38	90
Blue Clay	90	115
Mud	115	125
Blue Clay	125	170
Fine Sand	170	200
Sand	200	237
Blue Clay	237	250
Sand	250	278

WELL LOCATION:

sec. 24 T 7 S R. 15 W
1 miles NW of Kiln
 (distance) (direction) (nearest town)

WELL PURPOSE: Home
 (home, irrigation, municipal, industrial)

WELL COMPLETION DATA: 4 1/2

- (1) diameter (inches) 2
- (2) total depth (feet) 278
- (3) static water level (feet) 22 below top of ground.
- (4) casing Galv. 273
 (material) (depth)
2 If telescope see back.
 (size)
- (5) screen 5' 273
 (length) (depth to top)
2 S. Steel
 (size) (material)
- (6) pump 1/2 10
 (HP) (yield gpm)
Elec
 (type power)
- (7) electric log NO
 (yes or no)

CODED

(organization running log)

(8) how well bottom plugged B.W. Valve


DEC 7 8 1970

DRILLERS REMARKS:

MISS. BD. OF
 WATER CONTROL

If well telescopes please sketch and show depths.

GROUND LEVEL

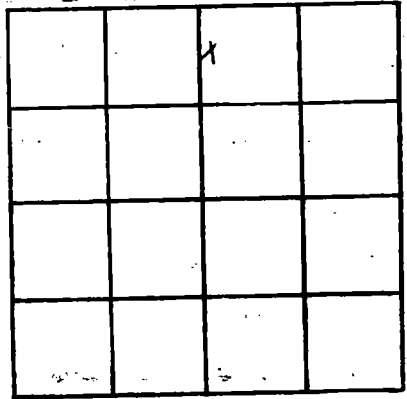

SECTION 24

Please indicate well location X.

ADDITIONAL INFORMATION

Lined area for additional information.

If more than one screen, show locations of each on sketch.