

HANCOCK
F 37
12-1-70

MISSISSIPPI
 BOARD OF WATER COMMISSIONERS
 416 North State Street
 Jackson, Mississippi 39201

CODED

WATER WELL DRILLERS LOG

12-1 1970 Penton Well Serv Hancock
 date well completed firm name county well located

LANDOWNER: Bart E. Cox
Box 194
Kiln Miss
 (mailing address)
 WELL LOCATION:
 sec 24 T 7 S R 15 W
1 miles NW of Kiln
 (distance) (direction) (nearest town)

description of formations encountered	from	to
Surface Clay	0	14
Sand	14	38
White Clay	38	105
Blue Clay	105	200
Fine sand	200	212
Blue Clay	212	253
Grey Sand	253	278

WELL PURPOSE: HOME
 (home, irrigation, municipal, industrial)

WELL COMPLETION DATA: 4 1/2
 (1) diameter (inches) 2
 (2) total depth (feet) 278
 (3) static water level (feet) 22 below top of ground.
 (4) casing Galv, 273,
 (material) (depth)
2 If telescope see back.
 (size)
 (5) screen 5', 273
 (length) (depth to top)
2, S. Steel
 (size) (material)
 (6) pump 1/2 10
 (HP) (yield gpm)
Elec
 (type power)
 (7) electric log NO
 (yes or no)
 (organization running log)
 (8) how well bottom plugged Ball Valve

CODED


DEC 16 1970

DRILLERS REMARKS:

MISS. BD. OF
 WATER COMM.

If well telescopes please sketch and show depths.

GROUND LEVEL

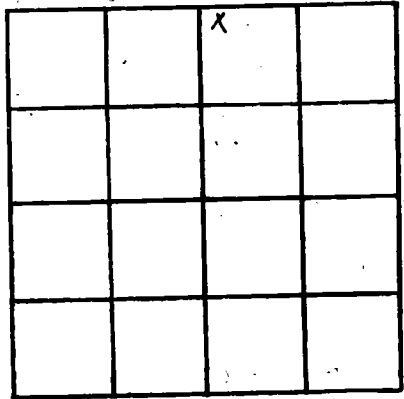

SECTION 24

Please indicate well location X.

ADDITIONAL INFORMATION

If more than one screen, show locations of each on sketch.