

HANCOCK
F 38
2-25-71

MISSISSIPPI
 BOARD OF WATER COMMISSIONERS
 416 North State Street
 Jackson, Mississippi 39201

CODED

WATER WELL DRILLERS LOG

2-25 1971 Penton Well Serv HANCOCK
 date well completed firm name county well located

LANDOWNER: Eric Larson
P.O. Box 142
KILN MISS
 (mailing address)

WELL LOCATION:
 sec. 24 T. 7 S. R. 15 W.
1 miles East of KILN
 (distance) (direction) (nearest town)

WELL PURPOSE: Home
 (home, irrigation, municipal, industrial)

- WELL COMPLETION DATA: 4 1/2
- (1) diameter (inches) 2
 - (2) total depth (feet) 1307
 - (3) static water level (feet) Flow ^{below} top of ground.
 - (4) casing Galv, 1287,
 (material) (depth)
2 if telescope see back.
 (size)
 - (5) screen 20', 1287
 (length) (depth to top)
2", S. Steel
 (size) (material)
 - (6) pump ✓ ✓
 (HP) (yield gpm)
✓
 (type power)
 - (7) electric log NO
 (yes or no)
- (organization running log)
- (8) how well bottom plugged Blw. Value

description of formations encountered	from	to
Surface Clay	0	38
Red sand	38	70
White Clay	70	90
Blue Clay	90	105
Mud	105	115
Blue Clay	115	245
Sand	245	330
Blue Clay	330	480
sand	480	585
Blue Clay	585	597
Sand	597	645
Blue Clay	645	680
Sand	680	770
Blue Clay	770	1240
Sand	1240	1307

CODED


MAR 25 1971

DRILLERS REMARKS: 25 lbs
Pressure at Ground
Level

MIGG. BD. OF
 WATER COMM.

If well telescopes please sketch and show depths.

GROUND LEVEL

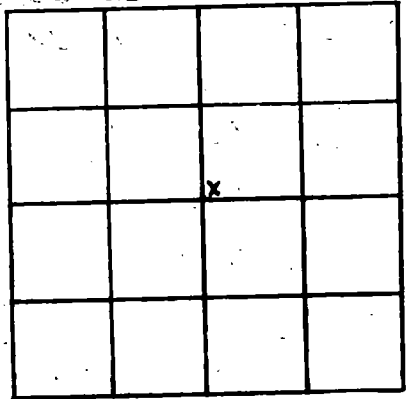

SECTION 24

Please indicate well location X.

ADDITIONAL INFORMATION

If more than one screen, show locations of each on sketch.