

HANCOCK
F41
8-2-72

MISSISSIPPI **CODED**
 BOARD OF WATER COMMISSIONERS
 416 North State Street
 Jackson, Mississippi 39201

WATER WELL DRILLERS LOG

8-2 19**72** **Earl Lester water well users** **Hancock**
 date well completed firm name county well located

LANDOWNER:
Johannie Lucius
KIN miss.
 (mailing address)

description of formations encountered	from	to
Red Clay + sd.	0	40
white med. sd.	40	64
white clay	64	90
Blue clay	90	240
med. Blue sd.	240	320

WELL LOCATION:
 sec. **24** T. **7** N. R. **15** E.
1 miles **NE** East of **Kin**
 (distance) (direction) (nearest town)

WELL PURPOSE: **Home**
 (home, irrigation, municipal, industrial)

- WELL COMPLETION DATA:**
- (1) diameter (inches) 4.5
 - (2) total depth (feet) 320
 - (3) static water level (feet) 20 below top of ground.
 - (4) casing Galv. 315
 (material) (depth)
2" if telescope see back.
 (size)
 - (5) screen 5' 315
 (length) (depth to top)
2" S.S.
 (size) (material)
 - (6) pump 1/2 400
 (HP) (yield gpm)
Elect
 (type power)
 - (7) electric log NO
 (yes or no)
- (organization running log)
- (8) how well bottom plugged Skoe


CODED

NOV 27 1972

DRILLERS REMARKS:

If well telescopes please sketch and show depths.

GROUND LEVEL

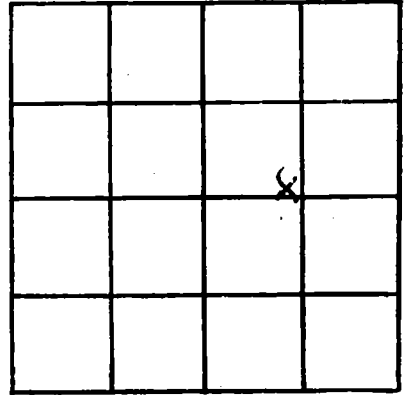

SECTION 24

Please indicate well location X.

ADDITIONAL INFORMATION

If more than one screen, show locations of each on sketch.