

Hancock
F 51
2-11-75

MISSISSIPPI
 BOARD OF WATER COMMISSIONERS
 416 North State Street
 Jackson, Mississippi 39201

CODED

WATER WELL DRILLERS LOG

7-11 1975 Penton Well Serv Hancock
 date well completed firm name county well located

LANDOWNER: Jan Ford
Rt. 1 Box 308
Bay St. - Louis MS
 (mailing address)

description of formations encountered	from	to
Surface Clay	0	20
Sand	20	70
Blue Clay	70	460
Fine Sand	460	570
Blue clay	570	640
Sand	640	680

WELL LOCATION:
 sec. 11 T. 7 S. R. 15 W. 135
3 1/2 miles NW of Kiln
 (distance) (direction) (nearest town)

WELL PURPOSE: Home
 (home, irrigation, municipal, industrial)

WELL COMPLETION DATA:

(1) diameter (inches) 2

(2) total depth (feet) 680

(3) static water level (feet) 32 below
 top of ground.

(4) casing Galv., 670,
 (material) (depth)
2 If telescope see back.
 (size)


(5) screen 10', 670
 (length) (depth to top)
2, S. Steel
 (size) (material)

(6) pump 1/2 7
 (HP) (yield gpm)
Elec
 (type power)

(7) electric log No
 (yes or no)

(8) how well bottom plugged Ball Valve
 (organization running log)

CODED

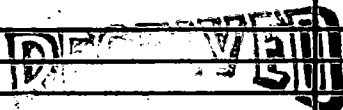

JUL 30 1975

DRILLERS REMARKS:

IF WATER COMME

If well telescopes please sketch and show depths.

GROUND LEVEL

		X	

SECTION 11

Please indicate well location X.

ADDITIONAL INFORMATION

If more than one screen, show locations of each on sketch.