

HANCOCK

F52

135

5-1-64

MISSISSIPPI BOARD OF WATER COMMISSIONERS

WATER WELL DRILLERS LOG

CODED

Date: 5-1, 1964, Driller: Sutter Well Works County Hancock

(Name)

(1) Owner of Land: Alfred Nease

(Name)

Kiln

(Address)

(2) Location: NE 1/4, SE 1/4, Sec. 24 T25R15W

1 miles N of Kiln (distance) (direction) (Nearest Town)

(3) Topography: Hilly (Hilly) (Flat) (Level)

(4) Purpose of Well: Domestic (Domestic Irrigation Municipal, Industrial, Other)

Description & Color of Materials Sand, Clay, Red Clay, Shell, etc.	Thick- ness Feet	Depth Feet
Yellow sandy clay	68	68
blue clay	252	320
sand	82	402
clay-sand st.	493	895
sand	70	965

Information upon completion of well:


- (1) Diameter 2 inches.
- (2) Total Depth 965 feet.
- (3) Water Level +26 feet above ground.
- (4) Cased to all, Size 2"
- (5) Screen: Size 2", Length 20'
- (6) Were any formations sealed against pollution?  
yes, no.

If YES depth of formation

Why

Drillers Remarks:

CODED

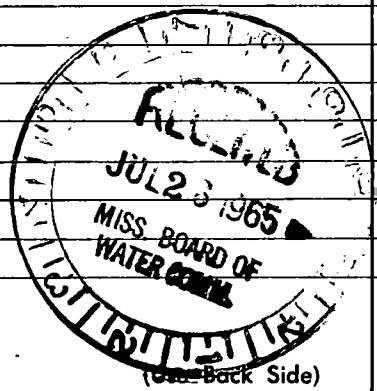

Well No.

Handwritten text at the top of the page, possibly a title or header.

81  
555  
273  
200

11 A 2 20 32 300

11 16

312.1

312.1

312.1

312.1