

HANCOCK  
 F-59  
 9-24-80

MISSISSIPPI  
 BOARD OF WATER COMMISSIONERS  
 416 North State Street  
 Jackson, Mississippi 39201

5  
 CODED

WATER WELL DRILLERS LOG

9-24-80 *Ermer Drilling Service, Inc.* Hancock  
 date well completed firm name county well located

LANDOWNER:	description of formations encountered	from	to
Tideway Energy Group P.O. Box 92 Jackson, Ms 39205 (mailing address)	clay	0	78
	clay sand	78	336
	sand	336	378
	clay	378	399
WELL LOCATION: 1485' N + 1239' W No 1 Burnt 23 T 7 N R 15 E of SE 1/4 Kiln (distance) (direction) (nearest town)			
WELL PURPOSE: <i>outfield supply</i> (home, irrigation, municipal, industrial)			
WELL COMPLETION DATA:			
(1) diameter (inches) 4"			
(2) total depth (feet) 399'			
(3) static water level (feet) 75' <sup>below</sup> <sub>above</sub> top of ground.			
(4) casing <i>Steel</i> 378' (material) (depth) 4" if telescope see back. (size)			
(5) screen 42' 336' (length) (depth to top) 4" perforated (size) (material)			
(6) pump 80 (HP) (yield gpm) AC (type power)			
(7) electric log _____ (yes or no) _____ (organization running log)			
(8) how well bottom plugged <i>orange</i> <i>peel</i>			
DRILLERS REMARKS:			

CODED


DEPT. OF NATURAL RESOURCES  
 BUREAU OF LAND & WATER RESOURCES

SEP 29 1980

RECEIVED

If well telescopes please sketch and show depths.

GROUND LEVEL

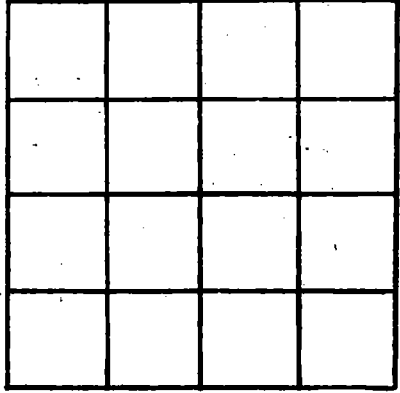

SECTION \_\_\_\_\_

Please indicate well location X.

ADDITIONAL INFORMATION

If more than one screen, show locations of each on sketch.