

F 2004

WATER WELL DRILLERS LOG

K

8-7-62

Date: 8-7, 1962, Driller: Sutter Well Works County Hancock


(Name)

	Description & Color of Materials Sand, Clay, Red Clay, Shell, etc.	Thick- ness Feet	Depth Feet
(1) Owner of Land: <u>LR Polit</u> (Name) <u>Shoreline Park - Bay St Louis</u> (Address)	<u>Sand</u>	<u>75</u>	<u>75</u>
(2) Location: <u>NE 1/4, SW 1/4, Sec. 40 T8S R14W</u>	<u>Clay</u>	<u>65</u>	<u>140</u>
<u>9</u> miles <u>NW</u> of <u>Bay St Louis</u> (distance) (direction) (Nearest Town)	<u>Sand</u>	<u>22</u>	<u>162</u>
(3) Topography: <u>Flat</u> (Hilly) (Flat) (Level)			
(4) Purpose of Well: <u>domestic</u> (Domestic Irrigation Municipal, Industrial, Other)			

Information upon completion of well:

- (1) Diameter 2 inches.
- (2) Total Depth 162 feet.
- (3) Water Level 8 feet below top of ground.
- (4) Cased to all, Size 2"
- (5) Screen: Size 2", Length 5'
- (6) Were any formations sealed against pollution?
no

If YES depth of formation _____
Why _____
Drillers Remarks: _____

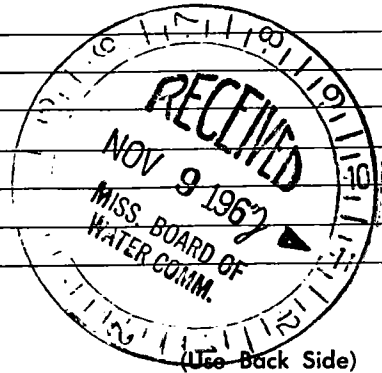

Well No.

