

Hancock  
F2014  
11/30/78

MISSISSIPPI  
BOARD OF WATER COMMISSIONERS  
416 North State Street  
Jackson, Mississippi 39201

WATER WELL DRILLERS LOG

11-30-1978 date well completed  
Micheal well works firm name  
Hancock county well located

LANDOWNER: Micheal Kohen  
705 Spruce St.  
Waveland, Ms.  
(mailing address)

WELL LOCATION:  
sec. 12 T. 7 N R. 15 E  
2 miles NW of Kuhn  
(distance) (direction) (nearest town)

WELL PURPOSE: home  
(home, irrigation, municipal, industrial)

WELL COMPLETION DATA:

(1) diameter (inches) 2"  
(2) total depth (feet) 480'  
(3) static water level (feet) 60' below top of ground.  
(4) casing PVC, 470' (material), (depth)  
If telescope see back.  
(5) screen 10' (length), (depth to top)  
2" (size), plastic (material)  
(6) pump 1 (HP), 12 (yield gpm)  
electric (type power)  
(7) electric log NO (yes or no)  
(organization running log)  
(8) how well bottom plugged sand shark


description of formations encountered	from	to
clay	0	18
sand	18	57
b. clay	57	231
slush	231	286
b. clay	286	325
slush	325	388
b. clay	388	410
c. sand	410	480

DRILLERS REMARKS:

Miss. Board of Water Comm.  
APR 6 - 1979  
RECEIVED

If well telescopes please sketch and show depths.

GROUND LEVEL

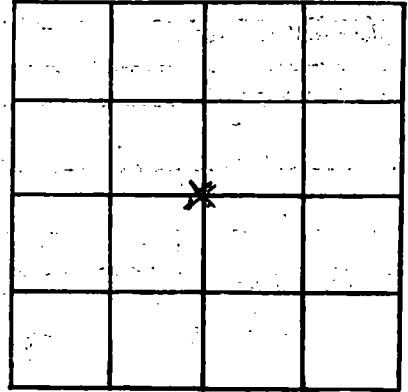

SECTION \_\_\_\_\_

Please indicate well location X.

ADDITIONAL INFORMATION

If more than one screen, show locations of each on sketch.