

Hancock
E 2015
12/14/78
12-14-1978
 date well completed

MISSISSIPPI
 BOARD OF WATER COMMISSIONERS
 416 North State Street
 Jackson, Mississippi 39201

WATER WELL DRILLERS LOG

McNeil well works
 firm name

Hancock
~~Harrison~~
 county well located

LANDOWNER: Joseph Sadner
Rt. 1 Box 419
P.O. Christian Miss.
 (mailing address)

WELL LOCATION:
 sec. 12 T. 7 N. R. 15 E
4 miles NW of Kilm
 (distance) (direction) (nearest town)

WELL PURPOSE: home
 (home, irrigation, municipal, industrial)


- WELL COMPLETION DATA:
- (1) diameter (inches) 2"
 - (2) total depth (feet) 265'
 - (3) static water level (feet) 45' ^{below} ~~above~~ top of ground.
 - (4) casing PVC, 255'
 (material) (depth)
— if telescope see back.
 (size)
 - (5) screen 10'
 (length) (depth to top)
2", plastic
 (size) (material)
 - (6) pump ? 10
 (HP) (yield gpm)
electric
 (type power)
 - (7) electric log no
 (yes or no)
—
 (organization running log)
 - (8) how well bottom plugged sand
spark

description of formations encountered	from	to
<u>clay</u>	<u>0</u>	<u>30</u>
<u>sand</u>	<u>30</u>	<u>90</u>
<u>B. clay</u>	<u>90</u>	<u>161</u>
<u>C. sand</u>	<u>161</u>	<u>200</u>
<u>D. sand</u>	<u>200</u>	<u>220</u>
<u>E. sand</u>	<u>220</u>	<u>265</u>

DRILLERS REMARKS:

Miss. Board of Water Comm.

APR 6 - 1979

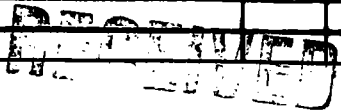

If well telescopes please sketch and show depths.

GROUND LEVEL

			X

SECTION _____

Please indicate well location X.

ADDITIONAL INFORMATION

If more than one screen, show locations of each on sketch.