

MISSISSIPPI DEPARTMENT OF NATURAL RESOURCES

Bureau of Land and Water Resources

Southport Mall

P.O. Box 10631

Jackson, Mississippi 39209

WATER WELL DRILLERS LOG

Hancock
F 2017

2-14- 1983 Wood Well Drilling Hancock
date well completed firm name county well located

LANDOWNER	description of formations encountered	from	to
<u>One Pumping Service</u>	<u>Clay</u>	<u>0</u>	<u>28</u>
<u>Hwy 43</u>	<u>ssly - clay</u>	<u>28</u>	<u>65</u>
<u>Kiln, Mr.</u>	<u>Clay - silt</u>	<u>65</u>	<u>176</u>
<u>(mailing address)</u>	<u>Case 51</u>	<u>176</u>	<u>210</u>

WELL LOCATION:
sec. 22 T. 10 N. R. 15 E.
12 miles N/W of Kiln
(distance) (direction) (nearest town)

WELL PURPOSE: None
(home, irrigation, municipal, industrial)

WELL COMPLETION DATA:

(1) diameter (inches) 2"

(2) total depth (feet) 210

(3) static water level (feet) 25 6 feet above top of ground.

(4) casing PVC, 200'
(material) (depth)
— If telescope see back.
(size)

(5) screen 10', —
(length) (depth to top)
2", PVC
(size) (material)

(6) pump 1, 15
(HP) (yield gpm)
Elec.
(type power)

(7) electric log NO
(yes or no)
N/A
(organization running log)

(8) how well bottom plugged BWU

DRILLERS REMARKS: N/A


DEPT. OF NATURAL RESOURCES
BUREAU OF LAND & WATER RESOURCES

MAR 21 1983

RECEIVED

If well telescopes please sketch and show depths.

GROUND LEVEL

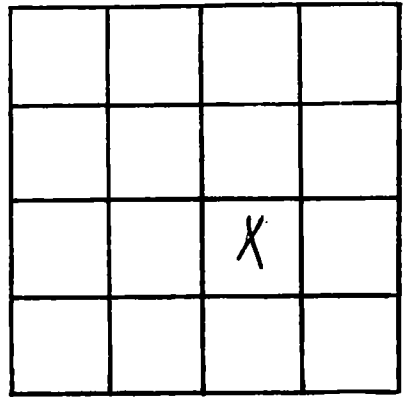

SECTION _____

Please indicate well location X.

ADDITIONAL INFORMATION

If more than one screen,
show locations of each on sketch.