

**MISSISSIPPI DEPARTMENT OF NATURAL RESOURCES**  
Bureau of Land and Water Resources

P.O. Box 10631

Jackson, Mississippi 39209  
**WATER WELL DRILLERS LOG**

COUNTY WELL LOCATED <b>Hancock</b>	
WELL NUMBER <b>F-2091</b>	CODED
DATE WELL COMPLETED <b>8-25-89</b>	

PERMIT NUMBER <b>0-493</b>
NAME OF DRILLING FIRM <b>Bobby Beck's Well Works, Inc.</b>

NAME & MAILING ADDRESS OF LANDOWNER <b>Mark Lecomme</b>			
<b>1701D Rd. 409</b>			
<b>Bay St. Louis MS 39320</b>			
WELL LOCATION:	SEC	TOWNSHIP	RANGE
	<b>25</b>	<b>7</b>	<b>15</b>
		<b>N</b>	<b>E</b>
		<b>S</b>	<b>W</b>
DISTANCE	DIRECTION	NEAREST TOWN	
_____ Miles	_____ of _____		
OTHER LANDMARK			
WELL PURPOSE <input checked="" type="checkbox"/> Home, <input type="checkbox"/> Irrigation, <input type="checkbox"/> Municipal, <input type="checkbox"/> Industrial, <input type="checkbox"/> Fish Pond, etc.			

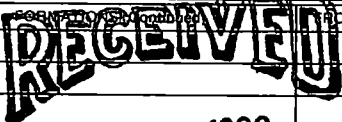
<b>PUMP DATA</b>		
PUMP TYPE (Circle One): Submersible, Turbine, Jet, Flowing Well, Other (Describe) <b>Top Stage</b>		
POWER TYPE (Circle One): <input checked="" type="checkbox"/> Electric, Tractor, Diesel, Gasoline, Butane, Other (Describe) <b>Top Stage</b>		
Pump Capacity (GPM) <b>1</b>	No. of Stages <b>2</b>	Setting Depth <b>0</b> FT.
PUMP TEST		
Well yielded _____ GPM with a drawdown of _____ ft. after _____ hours of pumping		

<b>WELL DATA</b>		
Well Depth <b>230</b>	Casing Diameter (In.) <b>2"</b>	Casing Length (Ft.) <b>20 ft.</b>
Type of Casing <b>PVC</b>	Hole Depth <b>2"</b>	Depth to Static Water Level <b>12 ft.</b>
TYPE OF COMPLETION: (Circle One or More): Gravel Packed, Underreamed, Telescoped, Natural Development, Open Hole, Other (Describe) _____		
Top of Lap Pipe or Reduction in Casing		
FEET	IF TELESCOPED OR MORE THAN ONE SCREEN: USE BACK PAGE	

<b>LOG DATA</b>	
TYPE OF LOG RUN (Circle One): No Log Run, Electric, Gamma Ray, Density, Sonic, Neutron, Other (Describe) _____	
Name of Organization Running Log <b>Bobby Beck's Well Works, Inc.</b>	

<b>SCREEN DATA</b>		
Diameter - Inches <b>2"</b>	Length - Feet <b>20 ft.</b>	Slot Size - Inches <b>#8</b>
Screen Type <b>Johnson Screen</b>	Depth to Bottom - Feet <b>230</b>	

<b>GEOLOGIC DATA (Office Use Only)</b>			
Surface Elev.	Geologic Unit	Unit Thickness	Depth to Top
Subs. SWL	Date	Analysis	Aquifer Test
Driller's Remarks			

DESCRIPTION OF FORMATIONS ENCOUNTERED	FROM	TO	DESCRIPTION OF FORMATIONS ENCOUNTERED	FROM	TO
 <b>MAY 15 1990</b> Department of Natural Resources Bureau of Land & Water Resources					
IF MORE SPACE IS NEEDED, USE BACK					

If well telescopes please sketch and show depths.

GROUND LEVEL


SECTION \_\_\_\_\_

Please indicate well location X.

ADDITIONAL INFORMATION

---

---

*(Faint, mirrored text, likely bleed-through from the reverse side of the page)*

If more than one screen, show location of each on sketch.