

HANCOCK MISSISSIPPI BOARD OF WATER COMMISSIONERS

G 2812
8-26-63

G
WATER WELL DRILLERS LOG

Date: 8-26, 1963, Driller: Hattiesburg Butan County, ~~Hattiesburg~~
(Name) Hancock

(1) Owner of Land: M. H. Buell
(Name)
Rocky Hill, Miss.
(Address)

(2) Location: 1/4, 1/4 Sec. T. R.
1/4 mile above Rocky Hill
miles, of Church
(distance) (direction) (Nearest Town)

(3) Topography: Hilly
(Hilly) (Flat) (Level)

(4) Purpose of Well: Domestic
(Domestic Irrigation
Municipal, Industrial, Other)

Description & Color of Materials Sand, Clay, Red Clay, Shell, etc.	Thick- ness Feet	Depth Feet
Yellow clay	0-	8
Red clay	8-	18
Red clay	18-	24
Yellow clay	25-	26
Brown clay	26	45
Brown sand	45-	50
Brown clay	50-	54
Blue sand	55-	58
Blue clay	58-	68
Brown clay	68-	72
Red sand	72-	80
Blue clay	80-	220
Blue sand	220-	235

Information upon completion of well:

(1) Diameter 2 inches.

(2) Total Depth 235 feet.

(3) Water Level 60 feet below top of ground.

(4) Cased to _____, Size _____


(5) Screen: Size 3", Length 8'

(6) Were any formations sealed against pollution?
_____ yes, no.

If YES depth of formation _____

Why _____

Drillers Remarks: _____

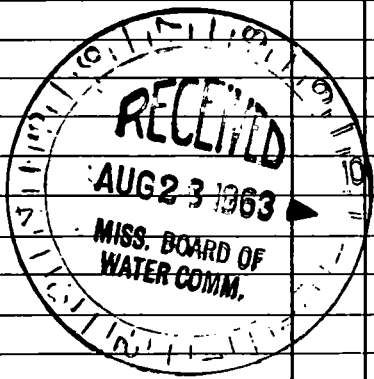

Well No.

(Use Back Side)