

HANCOCK

WATER WELL DRILLERS LOG

CODED

G

6-3-64

Date: 6-3, 1964, Driller: J. Beard

County Hancock

(Name)

(1) Owner of Land: Forrest Tcaire

(Name)

RT 1 Box 182 Cross Christian

(Address)

(2) Location: NW 1/4, NW 1/4, Sec. 6 T 7 R 4

8 miles N, of Tibo

(distance)

(direction)

(Nearest Town)

(3) Topography: X (Hilly) (Flat) (Level)

(4) Purpose of Well: Home

(Domestic Irrigation, Municipal, Industrial, Other)

Information upon completion of well:

(1) Diameter: 2 1/4 inches.

(2) Total Depth: 192 feet.

(3) Water Level: 40 feet below top of ground.

(4) Cased to: _____, Size: _____

(5) Screen: Size: 1/4, Length: 10 ft.

(6) Were any formations sealed against pollution?

_____ yes, _____ no.


If YES depth of formation: _____

Why: _____

Drillers Remarks: _____

Description & Color of Materials Sand, Clay, Red Clay, Shell, etc.	Thick- ness Feet	Depth Feet
Red clay & white sand	63	63
Hard Blue mud	27	90
Red mud & sand	30	120
Hard Hard Blue mud	52	172
water sand	20	192

CODED

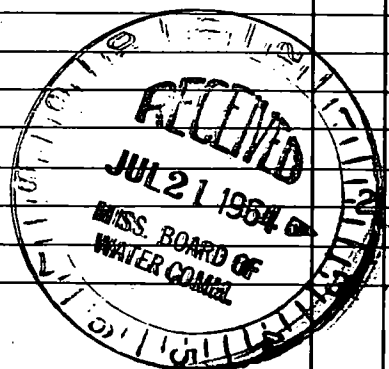

(Use Back Side)

Well No.

1100