

HANCOCK

WATER WELL DRILLERS LOG

6-5-64
6-8-64
Date: June 8, 1964

Driller: J. B. Reed
G. Hancock
(Name)

(1) Owner of Land: Donald Nease
 (Name)
RT 1 Box 100 Christian
 (Address)
 (2) Location: NE 1/4, SE 1/4, Sec. 6 T7 R14
7 miles N of Kilb
 (distance) (direction) (Nearest Town)
 (3) Topography: (Hilly) (Flat) (Level)
 (4) Purpose of Well: Home
 (Domestic Irrigation
 Municipal, Industrial, Other)


Description & Color of Materials Sand, Clay, Red Clay, Shell, etc.	Thick- ness Feet	Depth Feet
<u>Red Mud & sand</u>	<u>84</u>	<u>84</u>
<u>Hard Blue mud</u>	<u>166</u>	<u>250</u>
<u>Water strata</u>	<u>66</u>	<u>316</u>

Information upon completion of well:

(1) Diameter 2" x 1 1/4" inches.
 (2) Total Depth 316 feet.
 (3) Water Level 57 feet below top of ground.
 (4) Cased to _____, Size _____
 (5) Screen: Size 1 1/4", Length 10ft
 (6) Were any formations sealed against pollution?
 _____ yes, _____ no.

CODED

If YES depth of formation _____
 Why _____
 Drillers Remarks: _____

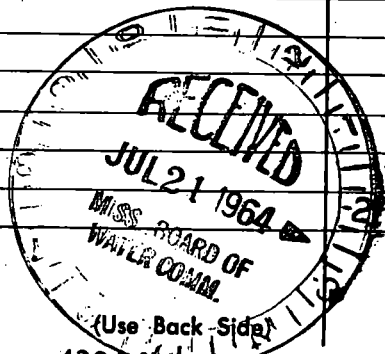

Well No.

