

HANCOCK
G 22
5-14-71

MISSISSIPPI
 BOARD OF WATER COMMISSIONERS
 416 North State Street
 Jackson, Mississippi 39201

CODED

WATER WELL DRILLERS LOG

5-14 1971 Panton Well Serv Hancock
 date well completed firm name county well located

LANDOWNER: Donald Hamby
Rt 2
Pass Christian, Miss
 (mailing address)

description of formations encountered	from	to
<u>Surface Clay</u>	<u>0</u>	<u>40</u>
<u>Sand</u>	<u>40</u>	<u>77</u>
<u>Blue Clay</u>	<u>77</u>	<u>280</u>
<u>Fine Sand</u>	<u>280</u>	<u>295</u>
<u>Blue Clay</u>	<u>295</u>	<u>340</u>
<u>Grey Sand</u>	<u>340</u>	<u>382</u>

WELL LOCATION:
 sec. 15 T. 7 R. 14
 S W
1 miles North of Fenton
 (distance) (direction) (nearest town)

WELL PURPOSE: Home
 (home, irrigation, municipal, industrial)

- WELL COMPLETION DATA:
- (1) diameter (inches) 2
 - (2) total depth (feet) 382
 - (3) static water level (feet) 11 below above top of ground.
 - (4) casing Galv 377
 (material) (depth)
2 If telescope see back.
 (size)
 - (5) screen 5' 377
 (length) (depth to top)
2 St. Steel
 (size) (material)
 - (6) pump 1/2 10
 (HP) (yield gpm)
Elec
 (type power)
 - (7) electric log NO
 (yes or no)
 (organization running log)
 - (8) how well bottom plugged Bw. Valve

CODED


JUN 16 1971

DRILLERS REMARKS:

MISS. BD. OF
 WATER COM.

If well telescopes please sketch and show depths.

GROUND LEVEL

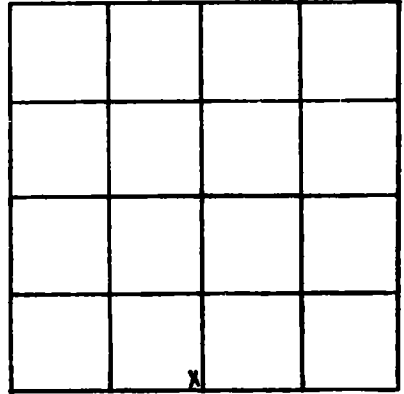

SECTION 15

Please indicate well location X.

ADDITIONAL INFORMATION

If more than one screen, show locations of each on sketch.