

Hancock  
G 30  
9-17-68

MISSISSIPPI  
BOARD OF WATER COMMISSIONERS  
416 North State Street  
Jackson, Mississippi 39201

CODED

CODED

WATER WELL DRILLERS LOG

9-17 1968 Sutter Well Works Hancock  
date well completed firm name county well located

LANDOWNER: Billy Lilla  
107 Hickory Lane  
Bay St Louis Miss.  
(mailing address)

description of formations encountered

from to

Clay	0	135
Sand	135	155
Clay	155	168
Sand	168	279
Clay	279	321
Sand	321	347
Clay	347	468
Sand	468	578
Clay	578	672
Clay, Sand streaks	672	740
Sand	740	785

WELL LOCATION:

sec 38 T 7 N S R 14 E W  
miles of (distance) (direction) (nearest town)


WELL PURPOSE:

Home  
(home, irrigation, municipal, industrial)

WELL COMPLETION DATA:

- diameter (inches) 2"
- total depth (feet) 785
- static water level (feet) ~~below~~ above top of ground.
- casing Galv (material), 765' (depth)  
2" (size) if telescope see back.
- screen 20' (length), 765' (depth to top)  
2" (size), Stainless Steel (material)
- pump none (HP) (yield gpm)  
(type power)
- electric log no (yes or no)  
(organization running log)
- how well bottom plugged BPU value

DRILLERS REMARKS:

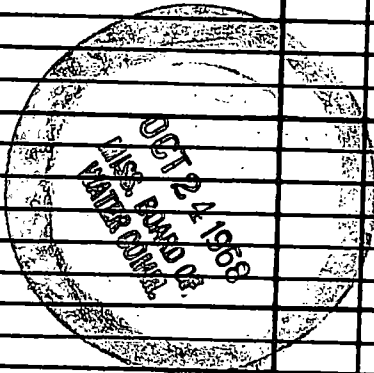

If well telescopes please sketch and show depths.

GROUND LEVEL


SECTION \_\_\_\_\_

Please indicate well location X.

ADDITIONAL INFORMATION

If more than one screen, show locations of each on sketch.