

Hancock  
G 32  
12-21-68

MISSISSIPPI  
 BOARD OF WATER COMMISSIONERS **FOD**  
 416 North State Street  
 Jackson, Mississippi 39201

WATER WELL DRILLERS LOG

Dec. 21 1968 Ladnier's Well Works Hancock  
 date well completed firm name county well located

LANDOWNER: Pinky  
Smith  
Poplarville Highway 24 1/2 mi  
 (mailing address)

WELL LOCATION:  
 sec. 3 T. 9 N. R. 14 W.  
8 miles north of Kiln  
 (distance) (direction) (nearest town)

WELL PURPOSE: Home  
 (home, irrigation, municipal, industrial)

- WELL COMPLETION DATA:
- (1) diameter (inches) 2 inch
  - (2) total depth (feet) 265
  - (3) static water level (feet) 80 below  
top of ground.
  - (4) casing Gal, 250,  
(material) (depth)  
2 inch If telescope see back.  
(size)
  - (5) screen 15, 250  
(length) (depth to top)  
2 inch, Stairhead  
(size) (material)
  - (6) pump 2 horse 8  
(HP) (yield gpm)  
Electric  
(type power)
  - (7) electric log no  
(yes or no)
  - (organization running log)
  - (8) how well bottom plugged Ball check

description of formations encountered	from	to
<u>yellow clay</u>	<u>60</u>	<u>feet</u>
<u>yellow sand</u>		
<u>iron</u>	<u>140</u>	<u>feet</u>
<u>yellow clay</u>	<u>50</u>	<u>feet</u>
<u>blue clay</u>	<u>150</u>	<u>feet</u>
<u>blue sand</u>	<u>15</u>	<u>feet</u>

INDEXED


MAR 6 1969

DRILLERS REMARKS:

MISS. BD. OF  
 WATER COMM.

If well telescopes please sketch and show depths.

GROUND LEVEL

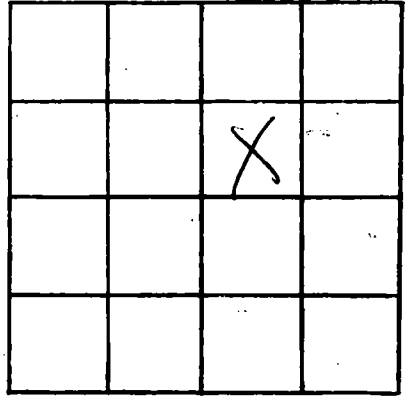

SECTION 2

Please indicate well location X.

ADDITIONAL INFORMATION

If more than one screen, show locations of each on sketch.