

Hancock
G 33
3-20-69

MISSISSIPPI
BOARD OF WATER COMMISSIONERS
416 North State Street
Jackson, Mississippi 39201

CODED
CODED

WATER WELL DRILLERS LOG

30 Mar 19 69 Pineville Water Works Hancock
date well completed firm name county well located

LANDOWNER: Glenn Stokell

R. F. D.

Kilms, Miss.
(mailing address)

WELL LOCATION:

sec 30 T 7 R 14
S W
miles Center of Kilms
(distance) (direction) (nearest town)

WELL PURPOSE: Home
(home, irrigation, municipal, industrial)

WELL COMPLETION DATA:

- (1) diameter (inches) 2"
- (2) total depth (feet) 210'
- (3) static water level (feet) 4' below top of ground.
- (4) casing Galv pipe 200'
(material) (depth)
- _____ if telescope see back.
(size)
- (5) screen 10' 200
(length) (depth to top)
- 2" S. S. screen
(size) (material)
- (6) pump 1/2 hp 800 GPM
(HP) (yield gpm)
- elec
(type power)
- (7) electric log No.
(yes or no)
- _____ (organization running log)

(8) how well bottom plugged 2" Spring
Check Back work well

DRILLERS REMARKS:

This is the first well I've built this

Description of formations encountered	from	to
Tap sand + small gravel	0	30
Red Clay or yellow	30	80
Blue pipe Clay	80	180
road core sand	180	200
Black pebbles		

I am sending my Personal check & money order

MAY 1 - 1969


MISS. BD. OF WATER COMMISSIONERS

Since Dec of 68 the 2nd day.

P.S. Please send some of your Envelopes
Herb

If well telescopes please sketch and show depths.

GROUND LEVEL

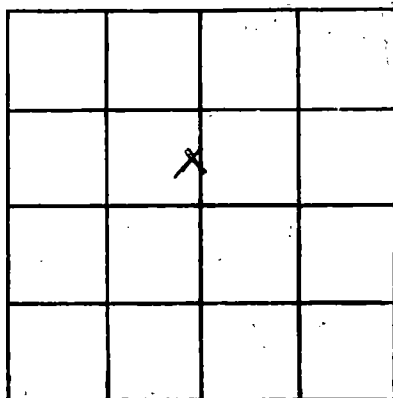

SECTION 30

Please indicate well location X.

ADDITIONAL INFORMATION

If more than one screen, show locations of each on sketch.