

Hancock  
G 39  
4-3-70

MISSISSIPPI  
 BOARD OF WATER COMMISSIONERS  
 416 North State Street  
 Jackson, Mississippi 39201

CODED

WATER WELL DRILLERS LOG

4-3 19 70 SUTTER WELL WORKS Hancock  
 date well completed firm name county well located

LANDOWNER: <u>ALINE CURET</u> <u>KILN, Miss.</u> (mailing address)	description of formations encountered	from	to
	<u>Clay</u>	<u>0</u>	<u>118</u>
	<u>Sand</u>	<u>118</u>	<u>138</u>
	<u>Clay</u>	<u>138</u>	<u>296</u>
	<u>Sand</u>	<u>296</u>	<u>320</u>
	<u>Clay</u>	<u>320</u>	<u>498</u>
	<u>Sand</u>	<u>498</u>	<u>594</u>

WELL LOCATION:  
 sec. 30 T. 7 N. R. 14 W.  
 (distance) 1/2 miles (direction) N of Kiln (nearest town)

WELL PURPOSE: home  
 (home, irrigation, municipal, industrial)

WELL COMPLETION DATA:

(1) diameter (inches) 2"

(2) total depth (feet) 594'

(3) static water level (feet) 25' below above top of ground

(4) casing galv 584'  
 (material) (depth)

2" If telescope see back.  
 (size)

(5) screen 10' 584'  
 (length) (depth to top)

2" stainless steel  
 (size) (material)

(6) pump none  
 (HP) (yield gpm)

(type power)

(7) electric log no  
 (yes or no)

(organization running log)

(8) how well bottom plugged BPU


DRILLERS REMARKS:

MAY 4 1970

MISS. BD. OF  
 WATER COMM.

If well telescopes please sketch and show depths.

GROUND LEVEL

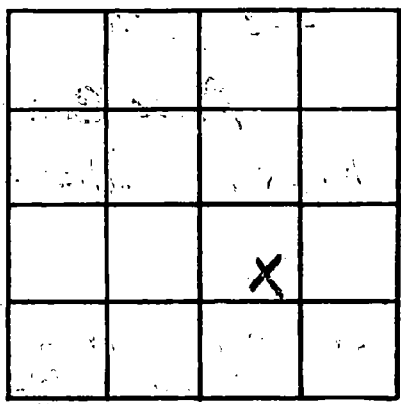

SECTION 30

Please indicate well location X.

ADDITIONAL INFORMATION

If more than one screen, show locations of each on sketch.