

Hancock
 G 40
 4-22-70

MISSISSIPPI
 BOARD OF WATER COMMISSIONERS
 416 North State Street
 Jackson, Mississippi 39201

CODED

WATER WELL DRILLERS LOG

April 22 1970 FAVRE WELL WORKS HANCOCK
 date well completed firm name county well located

LANDOWNER: Edward FAVRE
 Kals Mrs
 (mailing address)

WELL LOCATION:
 sec. 21 T 7 N R 14 E 142
 (distance) miles (direction) of (nearest town)

WELL PURPOSE: domestic
 (home, irrigation, municipal, industrial)

WELL COMPLETION DATA:

(1) diameter (inches) 7

(2) total depth (feet) 175

(3) static water level (feet) 3 below top of ground.

(4) casing Plastic, 175,
 (material) (depth)

(5) screen 5 ft., 175
 (length) (depth to top)

(6) pump Custom installed
 (HP) (yield gpm)
Pump
 (type power)

(7) electric log _____
 (yes or no)

(organization running log)

(8) how well bottom plugged Back wash well

description of formations encountered	from	to
Red Clay	0	10
Red & white clay	10	20
sand	20	30
Blue clay	30	40
" "	40	50
" "	50	60
" "	60	70
" "	70	90
" "	90	90
" "	90	100
Clay & shells	100	110
" "	110	120
Blue clay	120	130
" "	130	140
" "	140	150
" "	150	160
sand & clay	160	170
sand blue	170	170
wash down		<u>175</u>
5 ft in sand		


MAY 13 1970

MISS. BOARD OF WATER COMMISSIONERS

DRILLERS REMARKS:

If well telescopes please sketch and show depths.

GROUND LEVEL

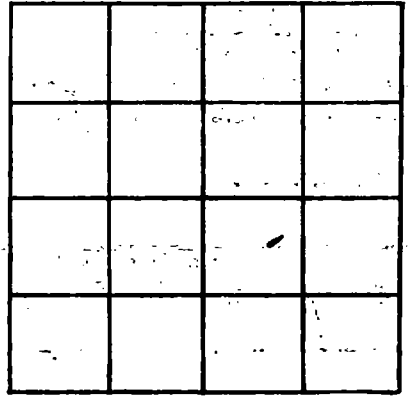

SECTION _____

Please indicate well location X.

ADDITIONAL INFORMATION

If more than one screen, show locations of each on sketch.