

HANCOCK  
G 53  
8-1-70

MISSISSIPPI  
BOARD OF WATER COMMISSIONERS  
416 North State Street  
Jackson, Mississippi 39201

**CODED**

WATER WELL DRILLERS LOG

8-1 1970 Penton Well Serv Hancock  
date well completed firm name county well located

LANDOWNER: O.B. DePro  
Rt. 1 Box 229  
Bay St Louis MISS  
(mailing address)

WELL LOCATION:  
sec. 30 T. 7 S. R. 14 W.  
0 miles of Kiln  
(distance) (direction) (nearest town)

WELL PURPOSE: HOME  
(home, irrigation, municipal, industrial)

WELL COMPLETION DATA:  
(1) diameter (inches) 2"  
(2) total depth (feet) 636  
(3) static water level (feet) flow below above top of ground.  
(4) casing Black, 616, (material) (depth)  
2 (size) if telescope see back.  
(5) screen 20', 616 (length) (depth to top)  
015 2, stainless (size) (material)  
(6) pump (HP) (yield gpm)  
(type power)  
(7) electric log NO (yes or no)  
(organization running log)  
(8) how well bottom plugged All Valve

description of formations encountered	from	to
Surface clay	0	18
Sand	18	26
Blue Clay	26	120
Grey sand	120	148
Blue Clay	148	165
Grey sand	165	285
Blue Clay	285	340
Grey sand	340	390
Blue Clay	390	410
Grey sand	410	453
Blue Clay	453	570
Grey sand	570	576
Blue Clay	570	610
Sand + Gravel	610	636

**CODED**


AUG 27 1970

DRILLERS REMARKS: 10 lbs Pressure at Ground level

MISS. BD. OF WATER COMMI.

If well telescopes please sketch and show depths.

GROUND LEVEL

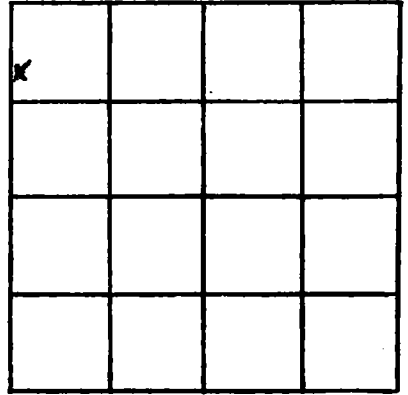

SECTION 30

Please indicate well location X.

ADDITIONAL INFORMATION

If more than one screen, show locations of each on sketch.