

HANCOCK
G 55
8-28-70

MISSISSIPPI
 BOARD OF WATER COMMISSIONERS
 416 North State Street
 Jackson, Mississippi 39201

CODED

WATER WELL DRILLERS LOG

SUTTER WELL WORKS

Hancock

8-28 1970
 date well completed

firm name

county well located

#6 LANDOWNER: Diamondhead Properties, Inc.

description of formations encountered

from

to

Bay St. Louis, Miss.
 (mailing address)

Clay

0

22

Sand

22

64

Clay

64

138

WELL LOCATION:

Sand

138

198

sec. 26 T 7 S

R. 14 W

Clay

198

276

Sand

276

325

2 1/2 miles SE of Fenton
 (distance) (direction) (nearest town)

WELL PURPOSE: home
 (home, irrigation, municipal, industrial)

WELL COMPLETION DATA:

(1) diameter (inches) 2" x 4"

(2) total depth (feet) 325'

(3) static water level (feet) 19' below above top of ground.

(4) casing galv. 315'
 (material) (depth)

2" & 4" if telescope see back.
 (size)

(5) screen 10' 315'
 (length) (depth to top)

2" stainless steel
 (size) (material)

(6) pump 1 20
 (HP) (yield gpm)

elec.
 (type power)

(7) electric log no
 (yes or no)

(organization running log)

(8) how well bottom plugged B.P. Valve

DRILLERS REMARKS:

CODED

OCT 19 1970
 MISS. Bd. OF
 WATER COMM.


If well telescopes please sketch and show depths.

GROUND LEVEL

84' of 4" galv.

231' of 2" galv.

10' of 2" screen

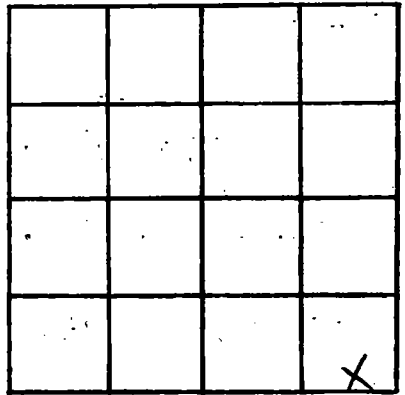

SECTION 26

Please indicate well location X.

ADDITIONAL INFORMATION

If more than one screen,
show locations of each on sketch.