

HANCOCK
G 64
2-1-71

MISSISSIPPI
 BOARD OF WATER COMMISSIONERS
 416 North State Street
 Jackson, Mississippi 39201

CODED

WATER WELL DRILLERS LOG

Feb. 1 19 71 M+W DRILLING CO. HANCOCK
 date well completed firm name county well located

LANDOWNER: LARRY NECAISE
Mi-WAY 603
PASS CHRISTIAN, MISS.
 (mailing address)

description of formations encountered	from	to
<u>CLAY</u>	<u>0</u>	<u>40</u>
<u>SAND</u>	<u>40</u>	<u>65</u>
<u>CLAY</u>	<u>65</u>	<u>80</u>
<u>SAND</u>	<u>80</u>	<u>96</u>
<u>CLAY</u>	<u>96</u>	<u>180</u>
<u>SAND</u>	<u>180</u>	<u>242</u>

WELL LOCATION:
 sec. 7 T. 7 N. R. 14 E.
20 miles N of DAY ST. LOUIS
 (distance) (direction) (nearest town)

WELL PURPOSE: HOME
 (home, irrigation, municipal, industrial)

- WELL COMPLETION DATA:
- (1) diameter (inches) 2"
 - (2) total depth (feet) 242'
 - (3) static water level (feet) 46' ^{below} top of ground.
 - (4) casing GAL. PIPE, 242'
 (material) (depth)
 (size) if telescope see back.
 - (5) screen 10', -
 (length) (depth to top)
10GA. STAINLESS STEEL
 (size) (material)
 - (6) pump 1/2 6
 (HP) (yield gpm)
ELEC.
 (type power)
 - (7) electric log NO
 (yes or no)
N/A
 (organization running log)
 - (8) how well bottom plugged B.W.U.

CODED


FEB 25 1971

DRILLERS REMARKS: off the
sand at 180 to approx. 202'
was of a fine grade. Got of
sd. picked up good down to
242'.

MISS. BD. OF
 WATER COMM.

If well telescopes please sketch and show depths.

GROUND LEVEL

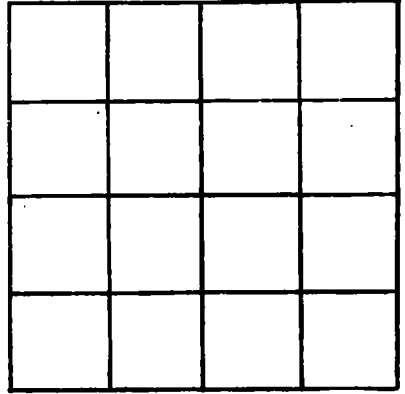

SECTION _____

Please indicate well location X.

ADDITIONAL INFORMATION

If more than one screen, show locations of each on sketch.