

HANCOCK
G-69
7-21-71

MISSISSIPPI
 BOARD OF WATER COMMISSIONERS
 416 North State Street
 Jackson, Mississippi 39201

WATER WELL DRILLERS LOG

CODED

7-21 1971 Fenton Well Serv Hancock
 date well completed firm name county well located

LANDOWNER: Curtis Deschamp
Rt. 1 Box 326
Pass Christian, Miss
 (mailing address)

WELL LOCATION:
 sec. 15 T. 7 N. R. 14 W.
1 miles North of Fenton
 (distance) (direction) (nearest town)

WELL PURPOSE: Home
 (home, irrigation, municipal, industrial)

WELL COMPLETION DATA:

(1) diameter (inches) 2

(2) total depth (feet) 367

(3) static water level (feet) 7 below top of ground.

(4) casing Galv 357
 (material) (depth)
2 if telescope see back.
 (size)

(5) screen 10' 357
 (length) (depth to top)
2 5. Steel
 (size) (material)

(6) pump 1/2 10
 (HP) (yield gpm)
Elec
 (type power)

(7) electric log No
 (yes or no)
 (organization running log)

(8) how well bottom plugged Ball Valve

description of formations encountered	from	to
Surface Clay	0	26
Sand	26	52
Blue Clay	52	116
Fine Sand	116	130
Blue Clay	130	165
Fine Sand	165	190
Blue Clay	190	320
Sand	320	367

CODED


AUG 3 - 1971

DRILLERS REMARKS:

MISS. BD. OF
 WATER COM.

If well telescopes please sketch and show depths.

GROUND LEVEL

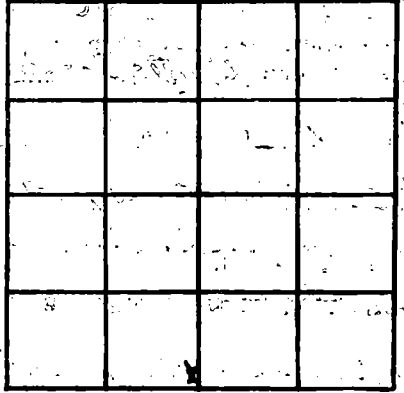

SECTION 15

Please indicate well location X.

ADDITIONAL INFORMATION

If more than one screen, show locations of each on sketch.