

HANCOCK
673
5-28-62

WATER WELL DRILLERS LOG

CODED

Date: 5-28, 1962, Driller: Tommy Reed County Hancock
(Name)

(1) Owner of Land Tommy Gonzales
(Name)
Kilm Mrs
(Address)

(2) Location: 1/4, 1/4, Sec. 38 T 7R14
1/2 miles EAST of Chunch
(distance) (direction) (Nearest Town)

(3) Topography: _____
(Hilly) (Flat) (Level)

(4) Purpose of Well: Home
(Domestic Irrigation
Municipal, Industrial, Other)

Description & Color of Materials Sand, Clay, Red Clay, Shell, etc.	Thick- ness Feet	Depth Feet
<u>Red Clay</u>	<u>10</u>	<u>10</u>
<u>White sand</u>	<u>30</u>	<u>40</u>
<u>White shell</u>	<u>70</u>	<u>110</u>
<u>Hard Blue Mud</u>	<u>60</u>	<u>170</u>
<u>Fine sand</u>	<u>20</u>	<u>190</u>
<u>stratta</u>	<u>30</u>	<u>230</u>

CODED

Information upon completion of well:

(1) Diameter 2" x 1/4 inches.

(2) Total Depth 230 feet.

(3) Water Level Ground level feet below top of ground.

(4) Cased to _____, Size _____

(5) Screen: Size 1 1/4", Length 10'


(6) Were any formations sealed against pollution?
_____ yes, _____ no.

If YES depth of formation _____

Why _____

Drillers Remarks: _____

Total Dept 230

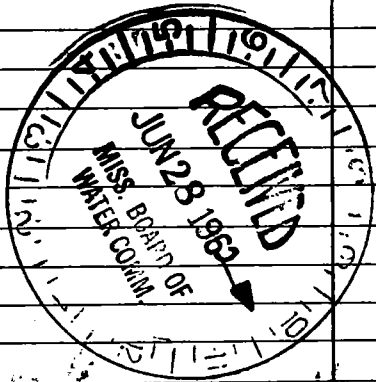

(Use Back Side)

Well No.

