

G 74
8-26-63

G WATER WELL DRILLERS LOG

CODED

Date: 8-26, 19 63 Driller: Hattiesburg Butane County Hancock
(Name)

(1) Owner of Land: Charles Hedo
(Name)
Rocky Hill, Miss
(Address)

(2) Location: 1/4, 27 28 14 Sec. 30 T. 6 R. 14
1 mile N of Rocky Hill
_____ miles _____ of Church
(distance) (direction) (Nearest Town)

(3) Topography: Hilly
(Hilly) (Flat) (Level)

(4) Purpose of Well: Domestic
(Domestic Irrigation
Municipal, Industrial, Other)

Description & Color of Materials Sand, Clay, Red Clay, Shell, etc.	Thick- ness Feet	Depth Feet
<u>Red Clay</u>	<u>0-</u>	<u>9</u>
<u>yellow Clay</u>	<u>9-</u>	<u>35</u>
<u>Blue Clay</u>	<u>35-</u>	<u>45</u>
<u>Blue sand</u>	<u>45-</u>	<u>70</u>
<u>Red sand</u>	<u>70-</u>	<u>90</u>
<u>Blue sand</u>	<u>90-</u>	<u>110</u>
<u>Gray sand</u>	<u>110-</u>	<u>120</u>
<u>Blue Clay</u>	<u>120-</u>	<u>130</u>
<u>Blue sand</u>	<u>130-</u>	<u>172</u>

Information upon completion of well:

(1) Diameter 3" inches.

(2) Total Depth 172 feet.


(3) Water Level 20 feet below top of ground.

(4) Cased to _____, Size _____.

(5) Screen: Size 3", Length 6'

(6) Were any formations sealed against pollution?
_____ yes, X no.

CODED

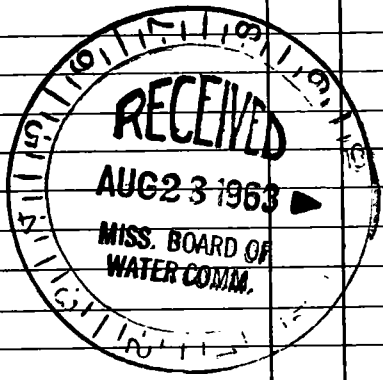

If YES depth of formation _____

Why _____

Drillers Remarks: _____

Well No.

(Use Back Side)

