

CODED

HANCOCK
G-76
5-13-71

MISSISSIPPI
 BOARD OF WATER COMMISSIONERS
 416 North State Street
 Jackson, Mississippi 39201

CODED

WATER WELL DRILLERS LOG

5-13 1971 Earl Penton water HANCOCK
 date well completed firm name county well located

LANDOWNER:
J.W. Brown
Kiln Miss.
 (mailing address)

description of formations encountered	from	to
	<u>Red Clay</u>	<u>0</u>
<u>Blue clay</u>	<u>3</u>	<u>163</u>
<u>Fine Blue sd.</u>	<u>163</u>	<u>178</u>
<u>Blue clay</u>	<u>178</u>	<u>192</u>
<u>Fine Blue sd.</u>	<u>192</u>	<u>218</u>
<u>Blue clay</u>	<u>218</u>	<u>245</u>
<u>Coarse G. sd.</u>	<u>245</u>	<u>258</u>

WELL LOCATION:
 sec. 8 T. 7 N R. 14 E
2 miles North of Kiln
 (distance) (direction) (nearest town)

WELL PURPOSE: Home
 (home, irrigation, municipal, industrial)

- WELL COMPLETION DATA:
- diameter (inches) 4 1/2
 - total depth (feet) 258
 - static water level (feet) 6" below top of ground.
 - casing Galv. 253
 (material) (depth)
2" If telescope see back.
 (size)
 - screen 5' 253-258
 (length) (depth to top)
2" S.S.
 (size) (material)
 - pump 1/2 450 H.
 (HP) (yield gpm)
Elect.
 (type power)
 - electric log NO
 (yes or no)
 - how well bottom plugged skoe

CODED


AUG 24 1971

MISS. BO. OF
 WATER COM.

DRILLERS REMARKS:

If well telescopes please sketch and show depths.

GROUND LEVEL

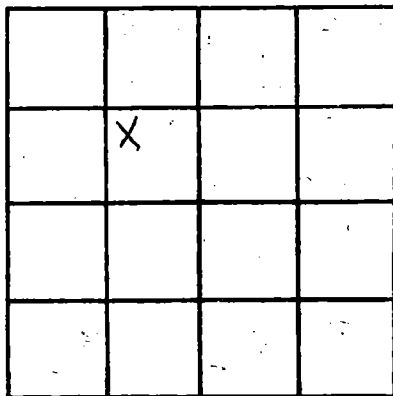

SECTION 8

Please indicate well location X.

ADDITIONAL INFORMATION

If more than one screen, show locations of each on sketch.