

MISSISSIPPI
BOARD OF WATER COMMISSIONERS
416 North State Street
Jackson, Mississippi 39201

WATER WELL DRILLERS LOG

CODED

HANCOCK

G 82

9-3-71

9-3 1971 **Earl Penton water well serv. Hancock**
date well completed firm name county well located

LANDOWNER:

Richard Lacoste

description of formations encountered

from

to

Kiln miss.
(mailing address)

Red clay 0 6
Red sd. & gravel 6 32

WELL LOCATION:

sec. **38** T **7** N R **14** E
1/2 miles **East** of **Kiln**
(distance) (direction) (nearest town)

White clay 32 64
Blue clay 64 176
Coarse Blue sd. & Gr. 176 272

WELL PURPOSE: **Home**
(home, irrigation, municipal, industrial)

Blue clay 272 330

WELL COMPLETION DATA:

- (1) diameter (inches) **4 1/2**
- (2) total depth (feet) **776**
- (3) static water level (feet) **22 1/2** below top of ground
- (4) casing **Galv. 756**
(material) (depth)
2" If telescope see back.
(size)
- (5) screen **20'** **756**
(length) (depth to top)
2" **S.S.**
(size) (material)
- (6) pump **1/2** **600 P.H.**
(HP) (yield gpm)
Elect.
(type power)
- (7) electric log **NO**
(yes or no)

Fine & medium Blue sd. 330 356
Blue clay 356 520
SOFT Blue clay 520 560
Coarse Gray sd. 560 609
SOFT Blue clay 609 730
Gray coarse sd. 730 776

CODED

NOV 29 1971


MISS. BD. OF
WATER COMM.

- (8) how well bottom plugged **Shoe**

DRILLERS REMARKS:

If well telescopes please sketch and show depths.

GROUND LEVEL

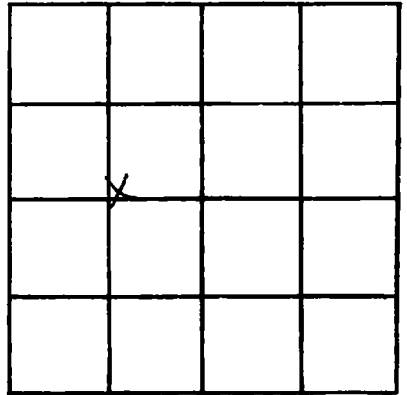

SECTION 38

Please indicate well location X.

ADDITIONAL INFORMATION

If more than one screen, show locations of each on sketch.