

HANCOCK  
G83  
12-20-71

MISSISSIPPI  
BOARD OF WATER COMMISSIONERS  
416 North State Street  
Jackson, Mississippi 39201

WATER WELL DRILLERS LOG

12-20 date well completed      71 Earl P. Ford water well Co. firm name      Hancock county well located

LANDOWNER:

Joe N. Case  
K. In MISS.  
(mailing address)

description of formations encountered

description of formations encountered	from	to
Red clay	0	10
white clay	10	18
Fine Red sd & c. covg	18	32
white clay	32	65
Blue clay	65	224
med blue sd.	224	250

WELL LOCATION:

sec 18 T 7 N R 14 E  
4 miles north of K. In  
(distance) (direction) (nearest town)

WELL PURPOSE:

Home  
(home, irrigation, municipal, industrial)

WELL COMPLETION DATA:

- (1) diameter (inches) 4 3/4
- (2) total depth (feet) 250
- (3) static water level (feet) 54 below top of ground.
- (4) casing Galv. 245 (material) (depth)  
(size) if telescope see back.
- (5) screen 5' 245 (length) (depth to top)  
2' 5.5 (size) (material)
- (6) pump 1 (HP) 430 H.V. (yield gpm)  
Elect (type power)
- (7) electric log NO (yes or no)

(organization running log)


(8) how well bottom plugged shoe

MAR 29 1972

DRILLERS REMARKS:

If well telescopes please sketch and show depths.

GROUND LEVEL

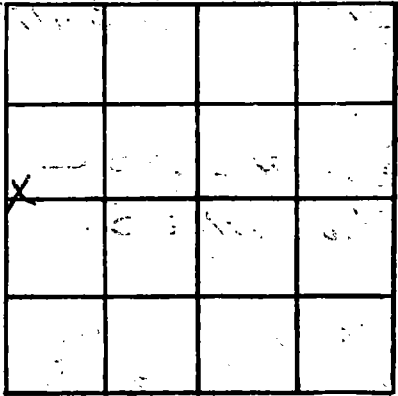

SECTION 18

Please indicate well location X.

ADDITIONAL INFORMATION

If more than one screen, show locations of each on sketch.