

HANCOCK
G 94
10-8-72

MISSISSIPPI
 BOARD OF WATER COMMISSIONERS
 416 North State Street
 Jackson, Mississippi 39201

WATER WELL DRILLERS LOG

10-8 1972 Pentecost Well Serv Hancock
 date well completed firm name county well located

LANDOWNER: Vernon H. Haas
Box 248
Kiln MISS
 (mailing address)

WELL LOCATION:
 sec 30 T 7 S R 14 E W
0 miles South of Kiln
 (distance) (direction) (nearest town)

WELL PURPOSE: Home
 (home, irrigation, municipal, industrial)

- WELL COMPLETION DATA:
- (1) diameter (inches) 2
 - (2) total depth (feet) 776
 - (3) static water level (feet) Flow above top of ground.
 - (4) casing Galv. 756
 (material) (depth)
2 If telescope see back.
 (size)
 - (5) screen 20' 756
 (length) (depth to top)
2 S.S. Steel
 (size) (material)
 - (6) pump ✓ ✓
 (HP) (yield gpm)
✓
 (type power)
 - (7) electric log NO
 (yes or no)
 (organization running log)
 - (8) how well bottom plugged B.W. Value


description of formations encountered	from	to
Surface clay	0	16
Sand	16	18
Red clay	18	24
Blue clay	24	170
Sand	170	210
Blue clay	210	280
Sand	280	305
Blue clay	305	540
Sand	540	585
Blue clay	585	610
Sand	610	640
Blue clay	640	710
Sand	710	776

DRILLERS REMARKS:
14 lbs. Pressure at
Ground level

NOV 15 1972

If well telescopes please sketch and show depths.

GROUND LEVEL

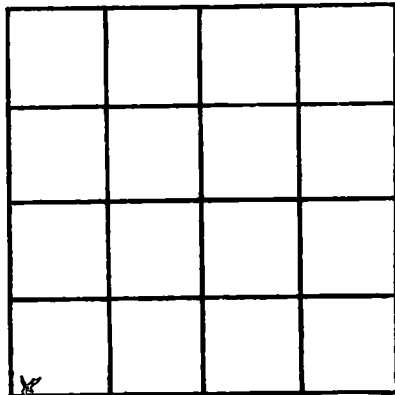

SECTION 30

Please indicate well location X.

ADDITIONAL INFORMATION

If more than one screen, show locations of each on sketch.