

HANCOCK  
G 95  
10-19-72

MISSISSIPPI  
 BOARD OF WATER COMMISSIONERS  
 416 North State Street  
 Jackson, Mississippi 39201  
**WATER WELL DRILLERS LOG**


10-19 19 72 Sutter Well Works Hancock  
 date well completed firm name county well located

LANDOWNER: <u>E. A. Lott</u> <u>109 Vance Pl.</u>	description of formations encountered	from	to
<u>Long Beach, Miss.</u> (mailing address)	<u>Clay</u>	<u>0</u>	<u>212</u>
	<u>Sand</u>	<u>212</u>	<u>232</u>
<b>WELL LOCATION:</b>	<u>Clay</u>	<u>232</u>	<u>490</u>
sec. <u>20</u> T <u>7</u> <del>XXX</del> R <u>14</u> <del>XX</del> S W <u>1</u> miles <u>N</u> of <u>Kiln</u> (distance) (direction) (nearest town)	<u>Sand</u>	<u>490</u>	<u>540</u>
<b>WELL PURPOSE:</b> <u>home</u> (home, irrigation, municipal, industrial)			
<b>WELL COMPLETION DATA:</b>			
(1) diameter (inches) <u>2"</u>			
(2) total depth (feet) <u>540'</u>			
(3) static water level (feet) <u>2</u> <del>XXXX</del> top of ground. above			
(4) casing <u>galv.</u> , <u>525'</u> (material) (depth) <u>2"</u> (size) if telescope see back.			
(5) screen <u>15'</u> , <u>525'</u> (length) (depth to top) <u>2"</u> <u>stainless steel</u> (size) (material)			
(6) pump <u>1/2</u> , <u>10</u> (HP) (yield gpm) <u>elec.</u> (type power)			
(7) electric log <u>no</u> (yes or no)			
(organization running log)			
(8) how well bottom plugged <u>B.P. Valve</u>			
<b>DRILLERS REMARKS:</b>			

NOV 1 1972

If well telescopes please sketch and show depths.

GROUND LEVEL

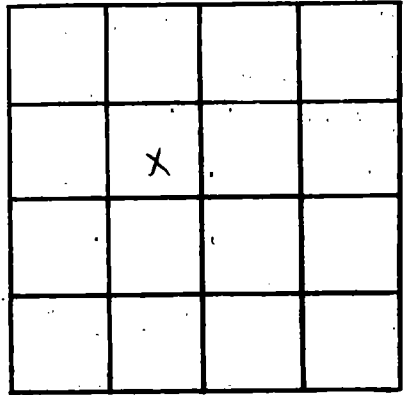

SECTION 20

Please indicate well location X.

ADDITIONAL INFORMATION

If more than one screen, show locations of each on sketch.