

**Hancock**  
**G 96**  
**1-24-72**

MISSISSIPPI  
 BOARD OF WATER COMMISSIONERS  
 416 North State Street  
 Jackson, Mississippi 39201

WATER WELL DRILLERS LOG

Jan. 24 1972 McMill Well Works Hancock  
 date well completed firm name county well located Hancock County

LANDOWNER: Amos W. Waters  
310 43 rd St.  
Gulf, MS.  
 (mailing address)

WELL LOCATION:  
 sec. 38 T. 7 N. R. 14 E.  
6 miles E of Delton  
 (distance) (direction) (nearest town)

WELL PURPOSE: None  
 (home, irrigation, municipal, industrial)


- WELL COMPLETION DATA:
- (1) diameter (inches) 2"
  - (2) total depth (feet) 577'
  - (3) static water level (feet) \_\_\_\_\_ below  
 top of ground. above
  - (4) casing gal. 567'  
 (material) (depth)  
 \_\_\_\_\_ If telescope see back.  
 (size)
  - (5) screen 10'  
 (length) (depth to top)  
2" 5.5  
 (size) (material)
  - (6) pump None 22 gal.  
 (HP) (yield gpm)  
flows.  
 (type power)
  - (7) electric log NO  
 (yes or no)  
NO  
 (organization running log)
  - (8) how well bottom plugged sample  
mark

Description of formations encountered	from	to
<u>well in Silver Creek Acres.</u>		
<u>sand</u>	<u>0</u>	<u>85</u>
<u>clay</u>	<u>85</u>	<u>90</u>
<u>sand</u>	<u>90</u>	<u>163</u>
<u>clay</u>	<u>163</u>	<u>240</u>
<u>sand</u>	<u>240</u>	<u>290</u>
<u>clay</u>	<u>290</u>	<u>305</u>
<u>course sand</u>	<u>305</u>	<u>577</u>
<u>22 gal a min of flowing</u>		

DRILLERS REMARKS:

If well telescopes please sketch and show depths.

GROUND LEVEL

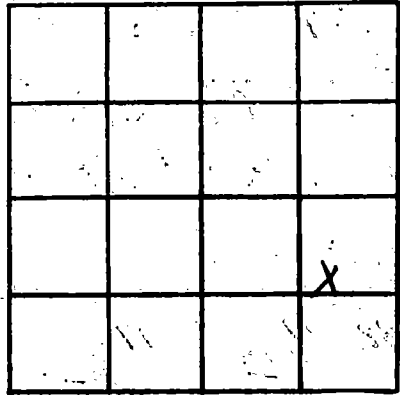

SECTION 38

Please indicate well location X.

ADDITIONAL INFORMATION

If more than one screen, show locations of each on sketch.