

**HANCOCK**  
**G 97**  
**7-24-72**

MISSISSIPPI  
 BOARD OF WATER COMMISSIONERS  
 416 North State Street  
 Jackson, Mississippi 39201

**CODED**

**WATER WELL DRILLERS LOG**


7-24 1972 Earl Penton water well serv. Hancock  
 date well completed firm name county well located

LANDOWNER:	description of formations encountered	from	to
<u>George Martin</u>			
<u>K. W. Miss.</u> (mailing address)	<u>Red &amp; white co. sd.</u>	<u>15</u>	<u>74</u>
WELL LOCATION:	<u>White clay</u>	<u>74</u>	<u>87</u>
sec. <u>23</u> T. <u>7</u> N. R. <u>14</u> E.	<u>Blue clay</u>	<u>87</u>	<u>203</u>
<u>5</u> miles <u>East</u> of <u>Kiln</u> (distance) (direction) (nearest town)	<u>med. blue sd.</u>	<u>203</u>	<u>245</u>
WELL PURPOSE: <u>Home</u> (home, irrigation, municipal, industrial)	<u>Blue clay</u>	<u>245</u>	<u>278</u>
WELL COMPLETION DATA:	<u>Fine blue sd.</u>	<u>278</u>	<u>298</u>
(1) diameter (inches) <u>4 5/8</u>	<u>Blue clay</u>	<u>298</u>	<u>330</u>
(2) total depth (feet) <u>600'</u>	<u>Consolidated</u>	<u>330</u>	<u>378</u>
(3) static water level (feet) <u>15</u> below top of ground.	<u>Blue clay</u>	<u>378</u>	<u>545</u>
(4) casing <u>Galv.</u> <u>580</u> (material) (depth)	<u>Gray Co. sd. &amp; gravel</u>	<u>545</u>	<u>600</u>
<u>2"</u> (size) if telescope see back.			
(5) screen <u>20'</u> <u>580</u> (length) (depth to top)			
<u>2"</u> <u>S.S.</u> (size) (material)			
(6) pump <u>NO PUMP</u> (HP) (yield gpm)			
(type power)			
(7) electric log <u>NO</u> (yes or no)			
(organization running log)			
(8) how well bottom plugged <u>Shoe</u>			
DRILLERS REMARKS:			

NOV 27 1972

If well telescopes please sketch and show depths.

GROUND LEVEL

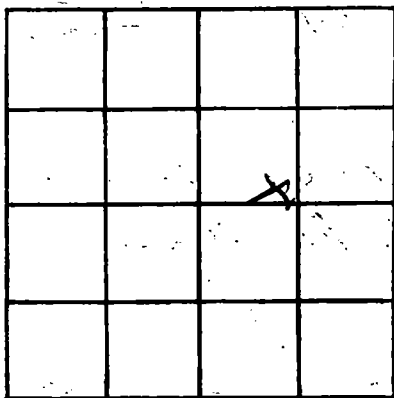

SECTION 23

Please indicate well location X.

ADDITIONAL INFORMATION

If more than one screen, show locations of each on sketch.