

MISSISSIPPI  
BOARD OF WATER COMMISSIONERS  
416 North State Street  
Jackson, Mississippi 39201

**CODED**

**WATER WELL DRILLERS LOG**

HANCOCK  
G 98  
12-14-72

12-14- 19 72 J.T. WARD WATER WELLS HANCOCK  
date well completed firm name county well located

LANDOWNER: JAMES FONTAINE  
RT. 1

PASS CHRISTIAN, MISS.  
(mailing address)

WELL LOCATION:  
sec 3 T 7 N R 14 E  
18 miles NW of B.S.L.  
(distance) (direction) (nearest town)

WELL PURPOSE: HOME  
(home, irrigation, municipal, industrial)

WELL COMPLETION DATA:

- (1) diameter (inches) 2"
- (2) total depth (feet) 277
- (3) static water level (feet) 40 below above top of ground.
- (4) casing 1" GALV. 267  
(material) (depth)  
- (size) if telescope see back.
- (5) screen 10' -  
(length) (depth to top)  
2" S.S.  
(size) (material)
- (6) pump 1 9  
(HP) (yield gpm)  
Elec.  
(type power)
- (7) electric log NO  
(yes or no)  
N/A  
(organization running log)
- (8) how well bottom plugged BWV


| description of formations encountered | from       | to         |
|---------------------------------------|------------|------------|
| <u>Clay 0-26</u>                      | <u>0</u>   | <u>26</u>  |
| <u>Orange SC.</u>                     | <u>26</u>  | <u>37</u>  |
| <u>Gray Clay silt SC.</u>             | <u>37</u>  | <u>112</u> |
| <u>SC.</u>                            | <u>112</u> | <u>175</u> |
| <u>Blue Clay SC.</u>                  | <u>175</u> | <u>237</u> |
| <u>SC.</u>                            | <u>237</u> | <u>277</u> |

JAN 8 1973

DRILLERS REMARKS: N/A

If well telescopes please sketch and show depths.

GROUND LEVEL

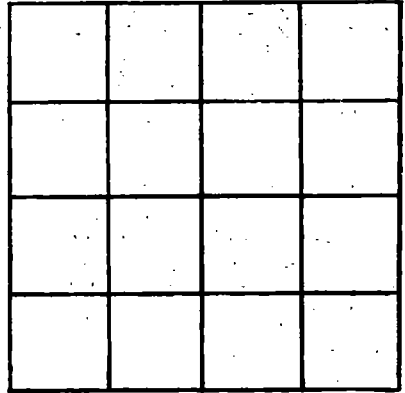

SECTION 3

Please indicate well location X.

ADDITIONAL INFORMATION

If more than one screen, show locations of each on sketch.