

HANCOCK
G 101
5-11-72

MISSISSIPPI
BOARD OF WATER COMMISSIONERS
416 North State Street
Jackson, Mississippi 39201

CODED

WATER WELL DRILLERS LOG

5/11/72 date well completed 1972 mcgill well works firm name Hancock county well located

LANDOWNER Lorne Nechomp
Bay St. Louis, Miss.
(mailing address)

WELL LOCATION:
sec 21 T 7 N R 14 E
3 miles W of Finton
(distance) (direction) (nearest town)

WELL PURPOSE: Home
(home, irrigation, municipal, industrial)

WELL COMPLETION DATA:

(1) diameter (inches) 2"
(2) total depth (feet) 572'
(3) static water level (feet) 489 p.m. below top of ground.
(4) casing gal. (material), 562' (depth)
- if telescope see back.
(5) screen 10' (length), - (depth to top)
2" (size), gal. (material)
(6) pump none (HP), 489 p.m. (yield gpm)
- (type power)
(7) electric log no (yes or no)
- (organization running log)
(8) how well bottom plugged Sand
shark

description of formations encountered	from	to
sand	0	78
Blue clay	78	121
fine sand	121	187
clay	187	221
Coarse sand shells	221	296
Coarse sand	296	318
clay	318	440
sand & gravel	440	489
	489	572


CODED

DRILLERS REMARKS: Si

SEP 10 1973

If well telescopes please sketch and show depths.

GROUND LEVEL

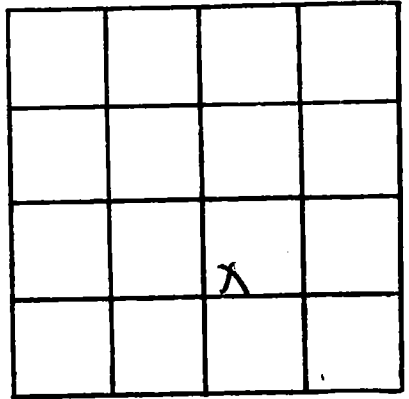

SECTION 21

Please indicate well location X.

ADDITIONAL INFORMATION

If more than one screen, show locations of each on sketch.