

HANCOCK

P.R.
G 104
6-5-73

MISSISSIPPI
 BOARD OF WATER COMMISSIONERS
 416 North State Street
 Jackson, Mississippi 39201

HANCOCK
 Pearl River

WATER WELL DRILLERS LOG


6-5-73 date well completed Earl Benton water well serv. firm name county well located

LANDOWNER:	description of formations encountered	from	to
<u>Mr. Namas Ledney</u>	<u>Red Clay</u>	<u>0</u>	<u>3</u>
<u>Pass Christian miss.</u> (mailing address)	<u>Red coarse sd.</u>	<u>3</u>	<u>25</u>
WELL LOCATION: sec <u>3</u> T <u>7</u> N R <u>14</u> E <u>6</u> miles <u>N.E.</u> of <u>Kiln</u> (distance) (direction) (nearest town)	<u>white clay</u>	<u>25</u>	<u>30</u>
	<u>med. white sd.</u>	<u>30</u>	<u>40</u>
WELL PURPOSE: <u>Home</u> (home, irrigation, municipal, industrial)	<u>white clay</u>	<u>40</u>	<u>128</u>
WELL COMPLETION DATA:	<u>Fine white sd.</u>	<u>128</u>	<u>144</u>
(1) diameter (inches) <u>4.5</u>	<u>Blue clay</u>	<u>144</u>	<u>346</u>
(2) total depth (feet) <u>376</u>	<u>Coarse Blue sd.</u>	<u>144</u>	<u>376</u>
(3) static water level (feet) <u>126</u> below/above top of ground.			
(4) casing <u>Galv.</u> <u>371</u> (material) (depth)			
<u>2</u> (size) if telescope see back.			
(5) screen <u>5</u> <u>371</u> (length) (depth to top)			
<u>2"</u> (size) <u>S.S.</u> (material)			
(6) pump <u>1</u> <u>270 Hr.</u> (HP) (yield gpm)			
<u>Elect</u> (type power)			
(7) electric log <u>NO</u> (yes or no)			
(organization running log)			
(8) how well bottom plugged <u>Shoe</u>			
DRILLERS REMARKS:			

CODED

If well telescopes please sketch and show depths.

GROUND LEVEL

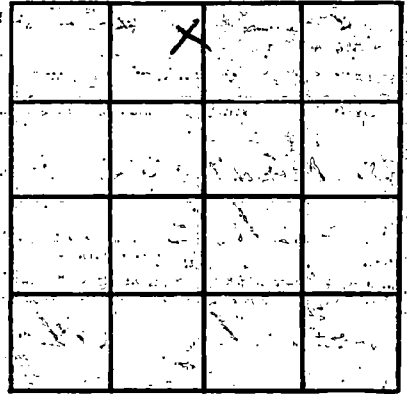

SECTION 3

Please indicate well location X.

ADDITIONAL INFORMATION

If more than one screen, show locations of each on sketch.