

MISSISSIPPI
BOARD OF WATER COMMISSIONERS
416 North State Street
Jackson, Mississippi 39201

CODED

WATER WELL DRILLERS LOG

Hancock

HANCOCK
G 106
6-20-73

6-20 1973 Earl Penton water well serv. Hancock
date well completed firm name county well located

LANDOWNER:	description of formations encountered	from	to
<u>Mr. C. Len Harris</u> <u>Kiln Miss</u> (mailing address)	<u>Red & white clay</u>	<u>0</u>	<u>16</u>
	<u>Sh. & Brown clay</u>	<u>16</u>	<u>32</u>
WELL LOCATION: sec <u>37</u> T <u>2</u> N R <u>14</u> E <u>3</u> miles <u>East</u> of <u>Kiln</u> (distance) (direction) (nearest town)	<u>Blue clay</u>	<u>32</u>	<u>60</u>
WELL PURPOSE: <u>Home</u> (home, irrigation, municipal, industrial)	<u>Fine Blue clay sd.</u>	<u>60</u>	<u>114</u>
WELL COMPLETION DATA:	<u>Blue clay</u>	<u>114</u>	<u>165</u>
(1) diameter (inches) <u>4.5</u>	<u>Fine Blue sd.</u>	<u>165</u>	<u>172</u>
(2) total depth (feet) <u>310</u>	<u>Blue clay</u>	<u>172</u>	<u>245</u>
(3) static water level (feet) <u>7'</u> below top of ground.	<u>med. Blue sd.</u>	<u>245</u>	<u>310</u>
(4) casing <u>Cole</u> <u>305</u> (material) (depth)			
<u>2"</u> If telescope see back. (size)			
(5) screen <u>5'</u> <u>305</u> (length) (depth to top)			
<u>2"</u> <u>S.S.</u> (size) (material)			
(6) pump <u>1</u> <u>500</u> (HP) (yield gpm)			
<u>Elect.</u> (type power)			
(7) electric log <u>NO</u> (yes or no)			
(organization running log)			
(8) how well bottom plugged <u>Shoe</u>			
DRILLERS REMARKS:			


CODED

NOV 8 1973

MISS. Bd. of WATER COMM.

If well telescopes please sketch and show depths.

GROUND LEVEL

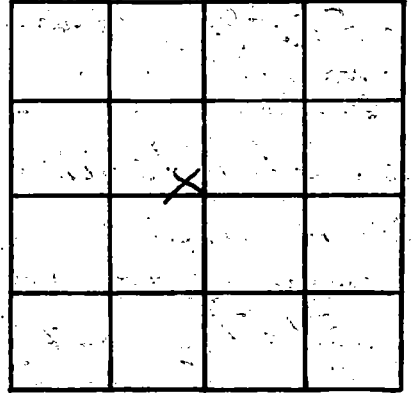

SECTION 37

Please indicate well location X.

ADDITIONAL INFORMATION

If more than one screen, show locations of each on sketch.