

**HANCOCK**  
**G 107**  
**12-17-73**

MISSISSIPPI *Walter Penton*  
 BOARD OF WATER COMMISSIONERS  
 416 North State Street  
 Jackson, Mississippi 39201

WATER WELL DRILLERS LOG **CODED**

12-17 1973 Penton Well Serv Hancock  
 date well completed firm name county well located

LANDOWNER: Olz Quarus  
Kiln, Miss  
 (mailing address)

description of formations encountered	from	to
Surface clay	0	30
Sand	30	55
Blue clay	55	220
Sand	220	257

WELL LOCATION:  
 sec 20 T 7 R 14  
 1 miles North of Kiln  
 (distance) (direction) (nearest town)

WELL PURPOSE: Home  
 (home, irrigation, municipal, industrial)

WELL COMPLETION DATA:

(1) diameter (inches) 2

(2) total depth (feet) 257

(3) static water level (feet) 16 below top of ground.

(4) casing Galv. 247  
 (material) (depth)  
2 if telescope see back.  
 (size)

(5) screen 10 247  
 (length) (depth to top)  
2 S. steel  
 (size) (material)


(6) pump 1/2 8  
 (HP) (yield gpm)  
Elec  
 (type power)

(7) electric log No  
 (yes or no)

(organization running log)

(8) how well bottom plugged BU Valve


**CODED**

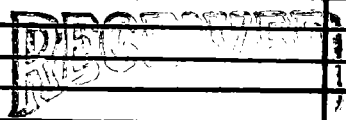

DRILLERS REMARKS:

If well telescopes please sketch and show depths.

GROUND LEVEL

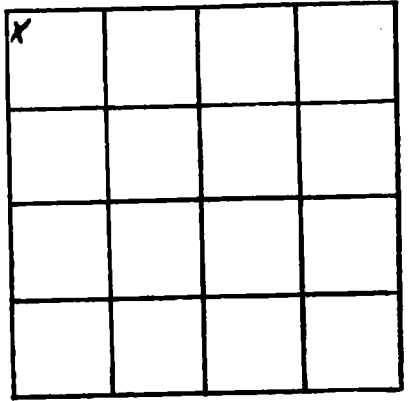

SECTION 20

Please indicate well location X.

ADDITIONAL INFORMATION

If more than one screen, show locations of each on sketch.